
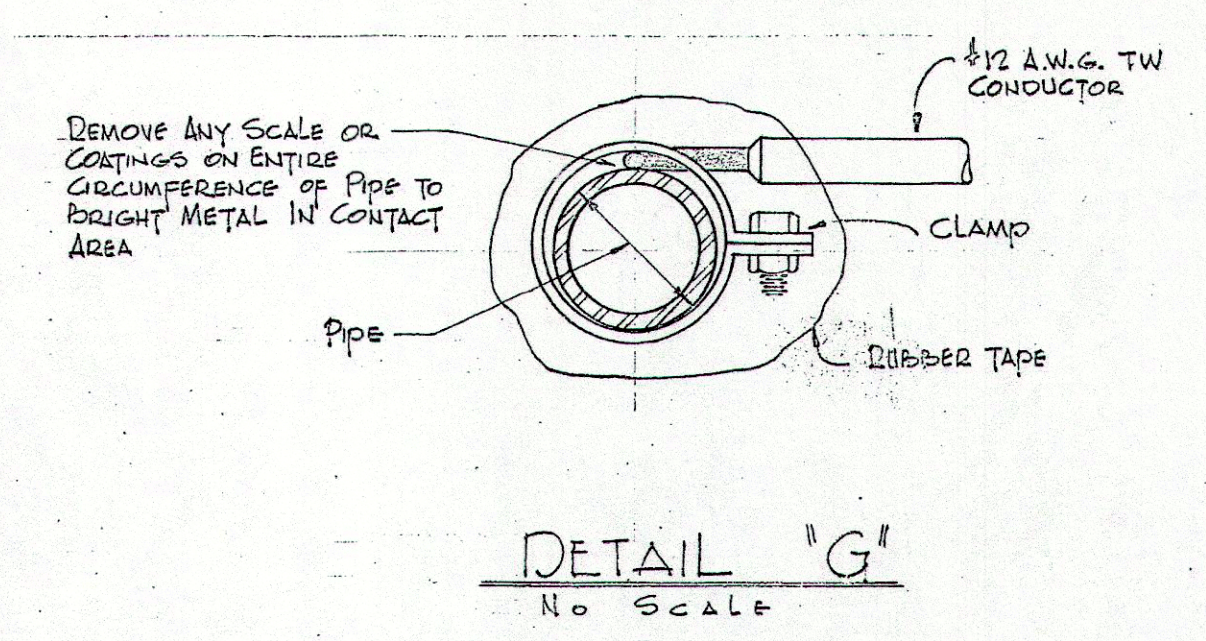
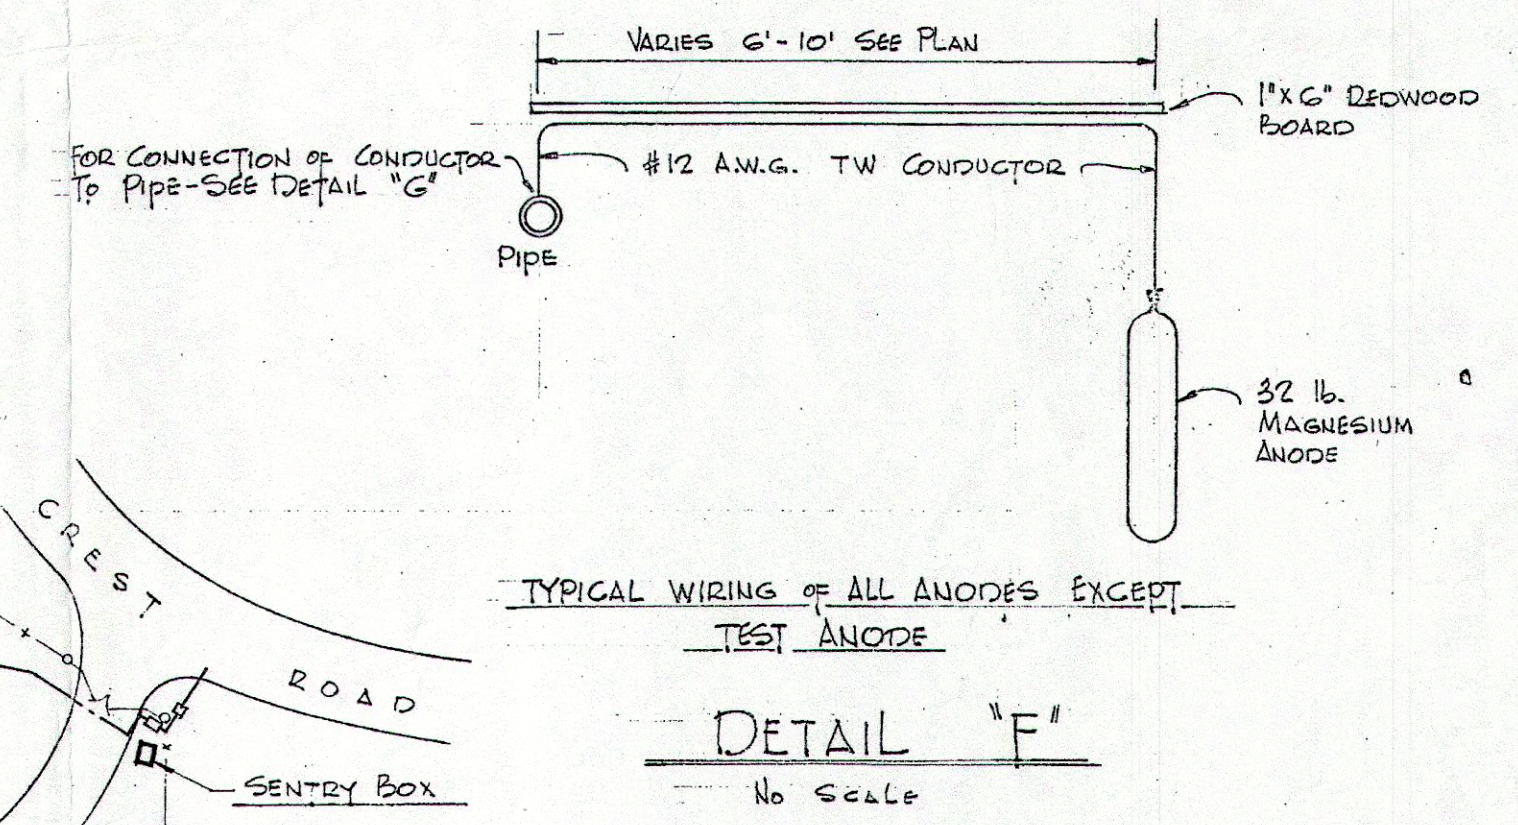


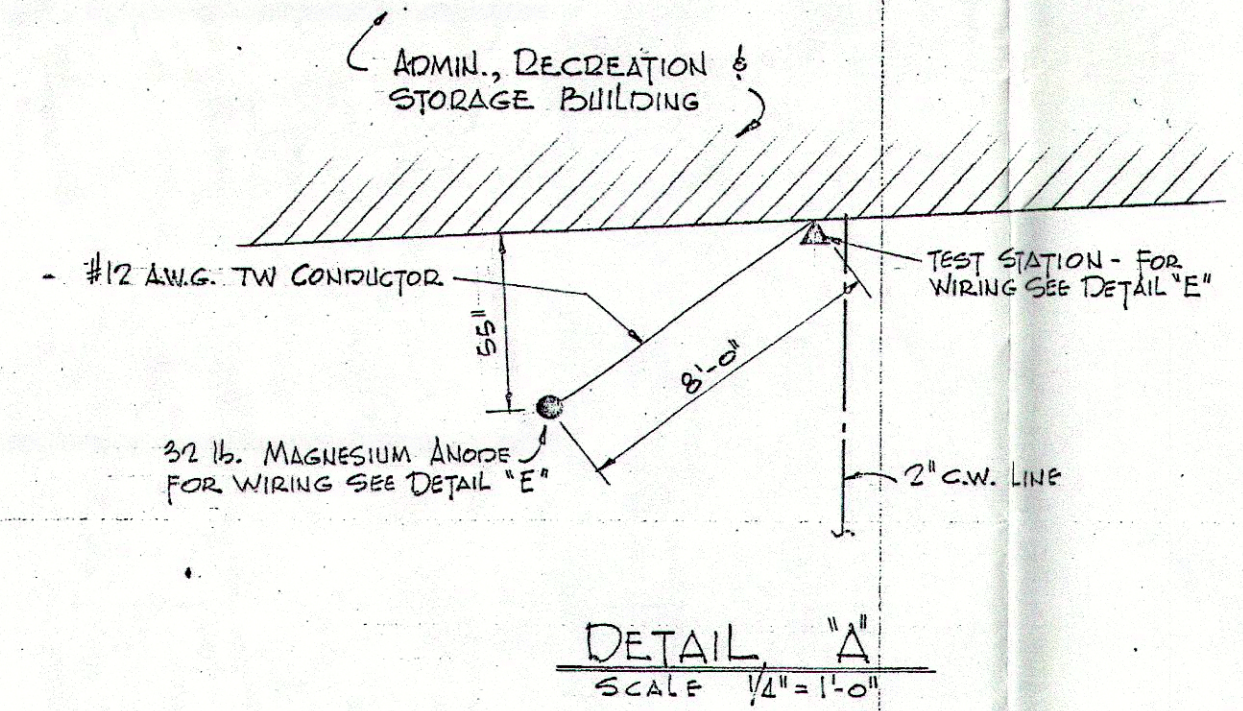





LEGEND

--- ABANDONED WATER LINE

--- EXISTING WATER LINE IN SERVICE


▲ TEST STATION (CATHODIC PROTECTION)

● ANODE (MAGNESIUM)

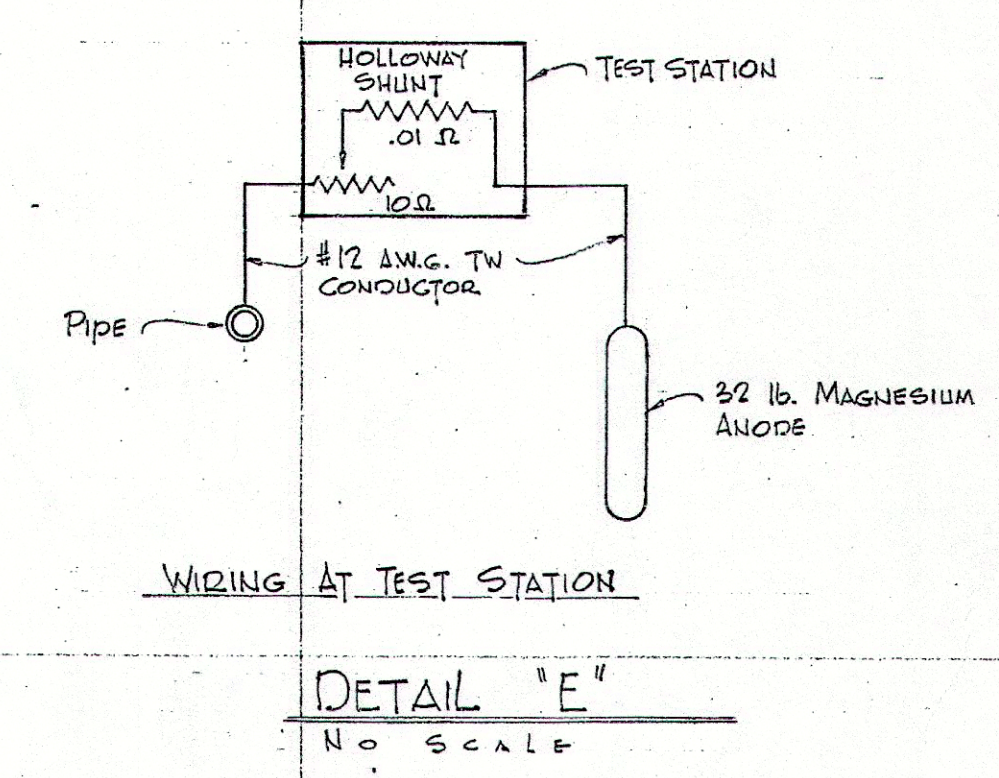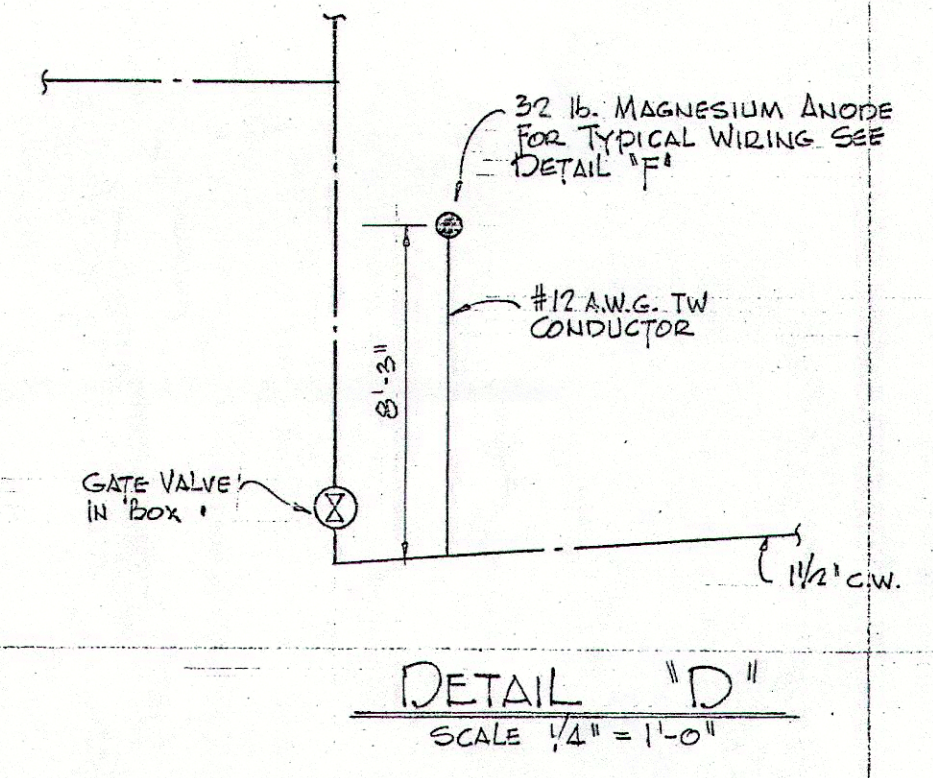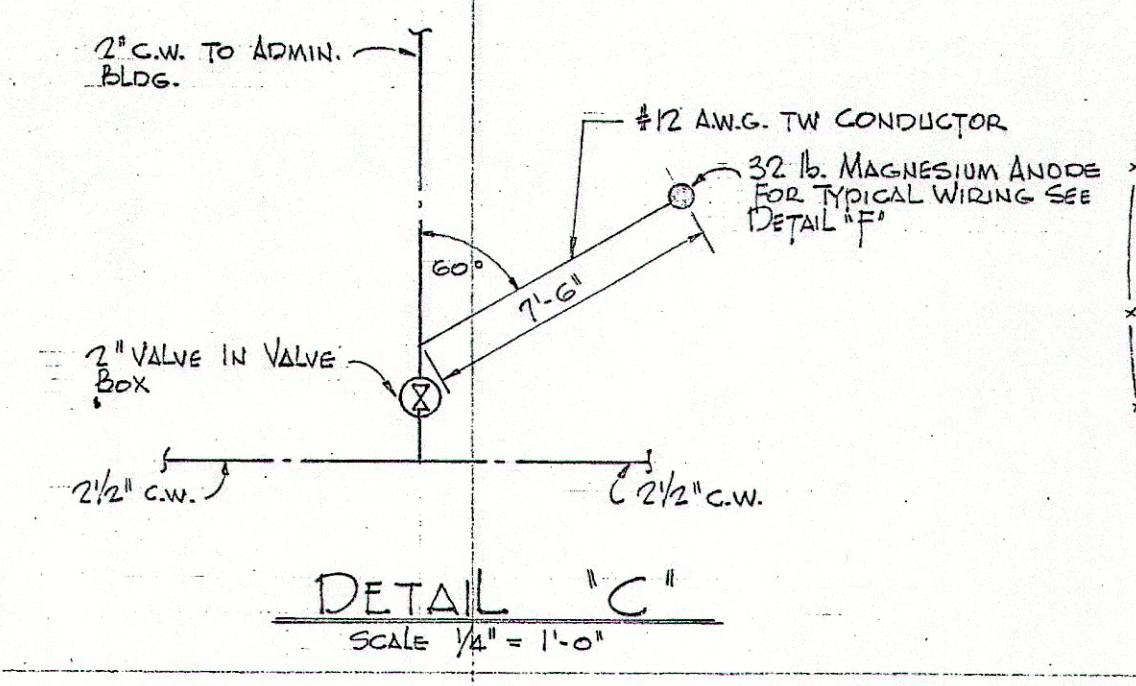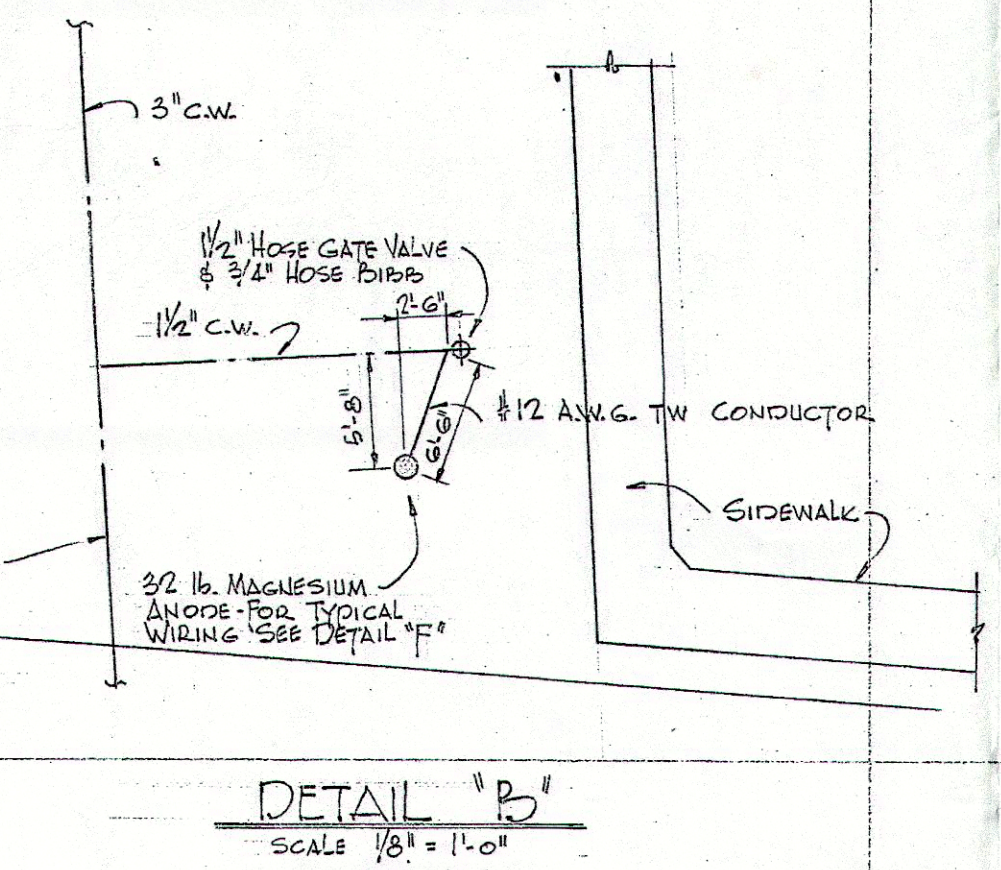

EXISTING WATER LINE EXPOSED DURING TRENCHING WORK (2011) FOR NEW WATER LINE REPLACEMENT. DEPTH: 3'

ABANDONED WATER LINE AS OF JULY 2011

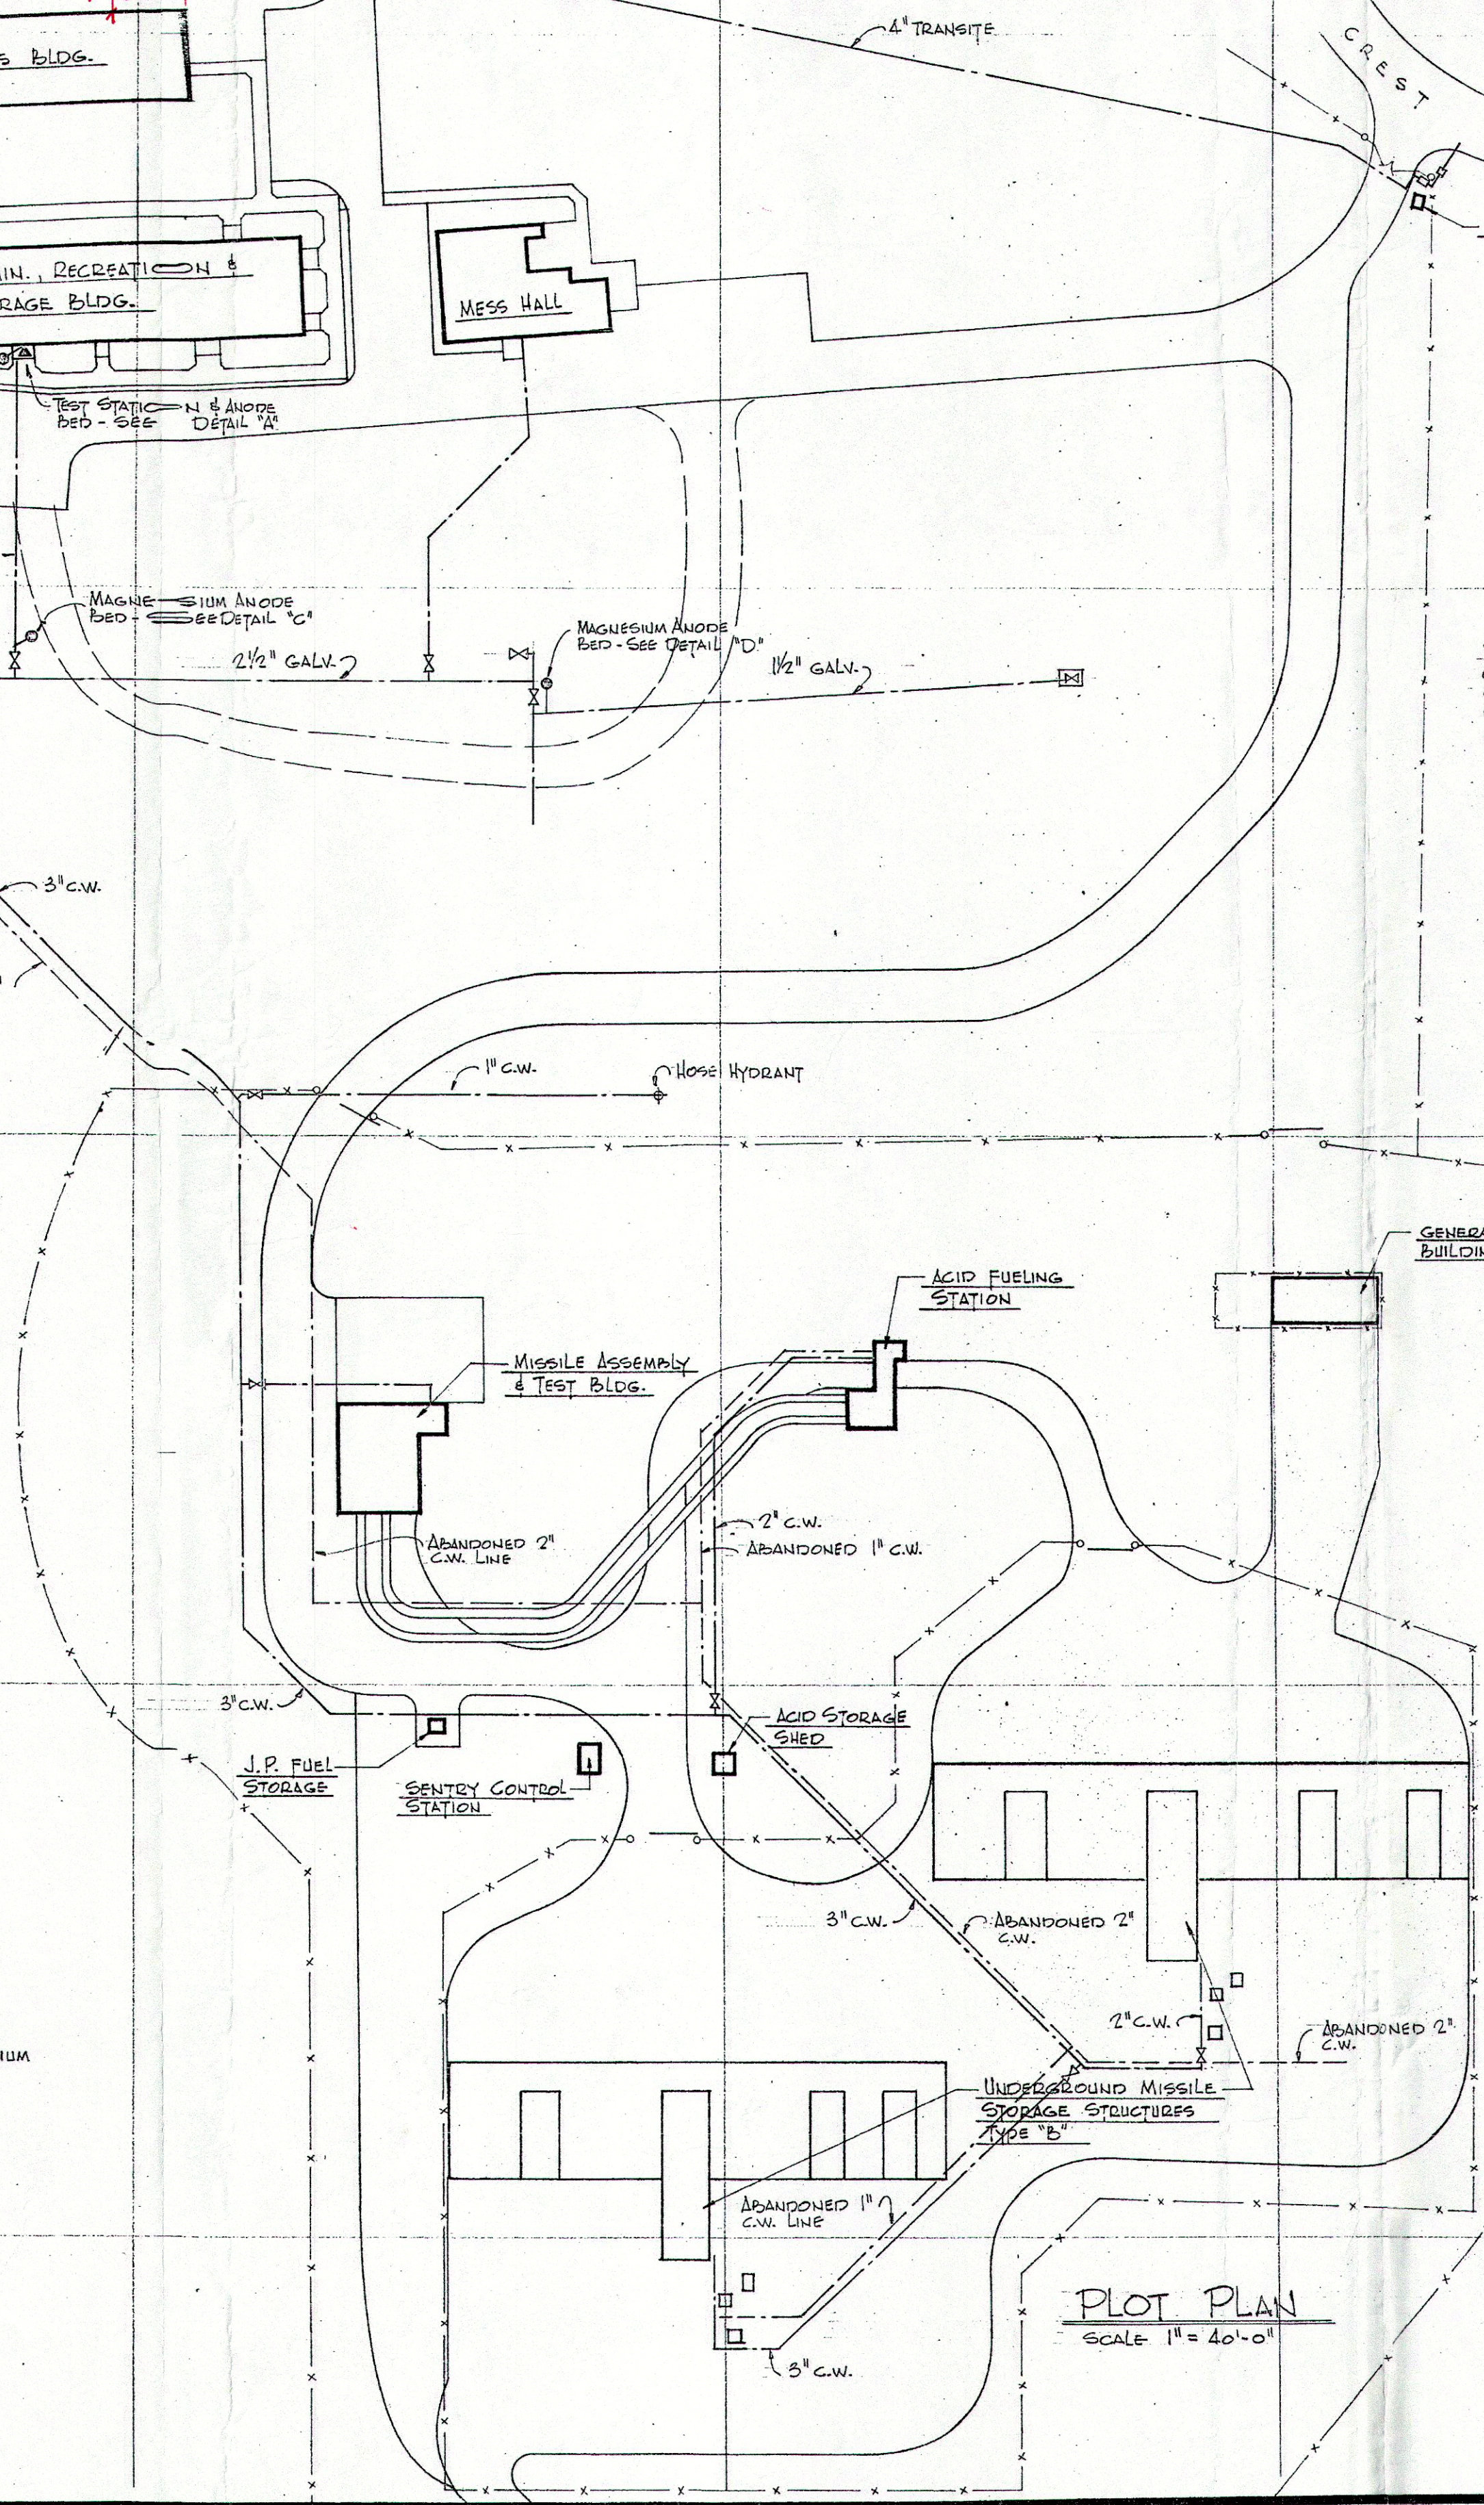

RECORD DRAWING - AS CONSTRUCTED

10 Apr '63

FORT MACARTHUR, CALIFORNIA		P.R. NO.
OFFICE OF THE POST ENGINEER		DRWG. NO.
PLOT PLAN & DETAILS		62-105
CATHODIC PROTECTION		SHEET
LA SITE 55		1
POINT VICENTE		OF 1 SHTS.
DRAWN BY: MISA	APPROVED: <i>Charles G. Hu Kee</i>	2 Apr 63
CHECKED BY:	LT. COL. C.E. POST ENGINEER	
SCALE: NOTED		