


Existing Transite

7/14/2011

CITY HALL MAIN WATER LINE Dimensions and distance references.

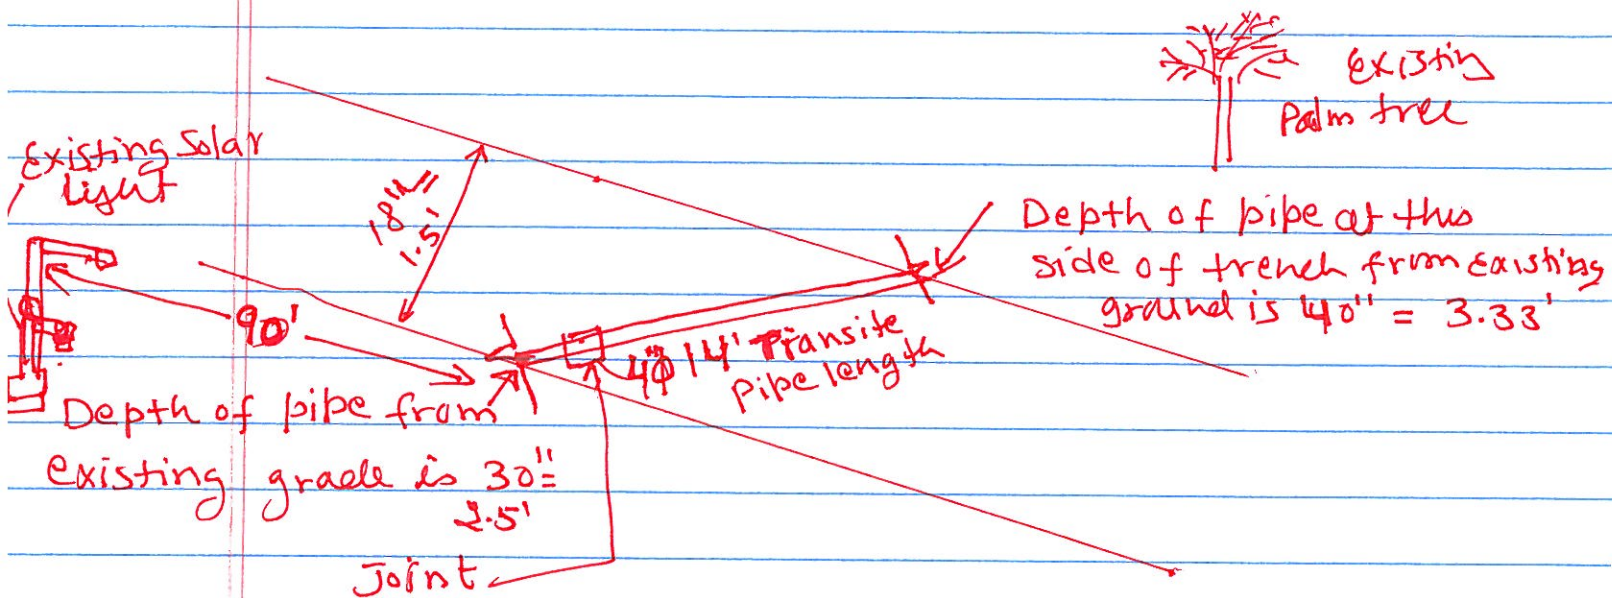

- Pipe distance from existing solar light is 90'.
- Distance for the pipe from existing Palm tree is ~~162"~~ 13.5'