




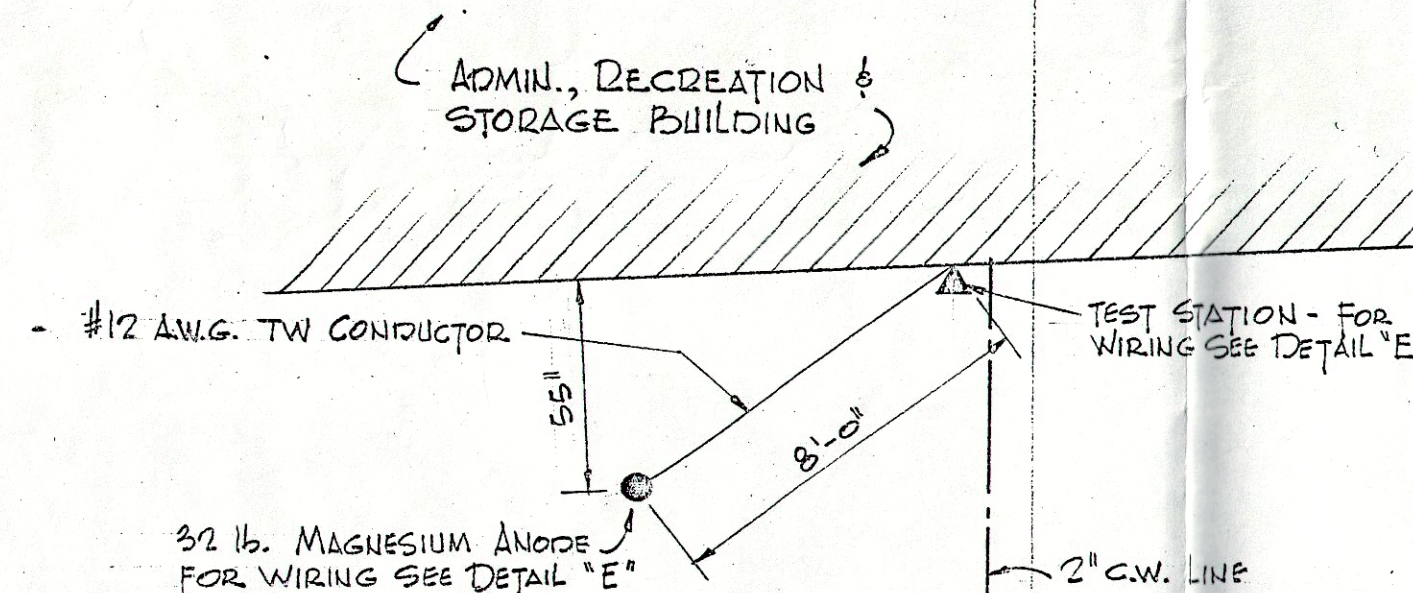

DETAIL "A"
SCALE 1/4" = 1'-0"


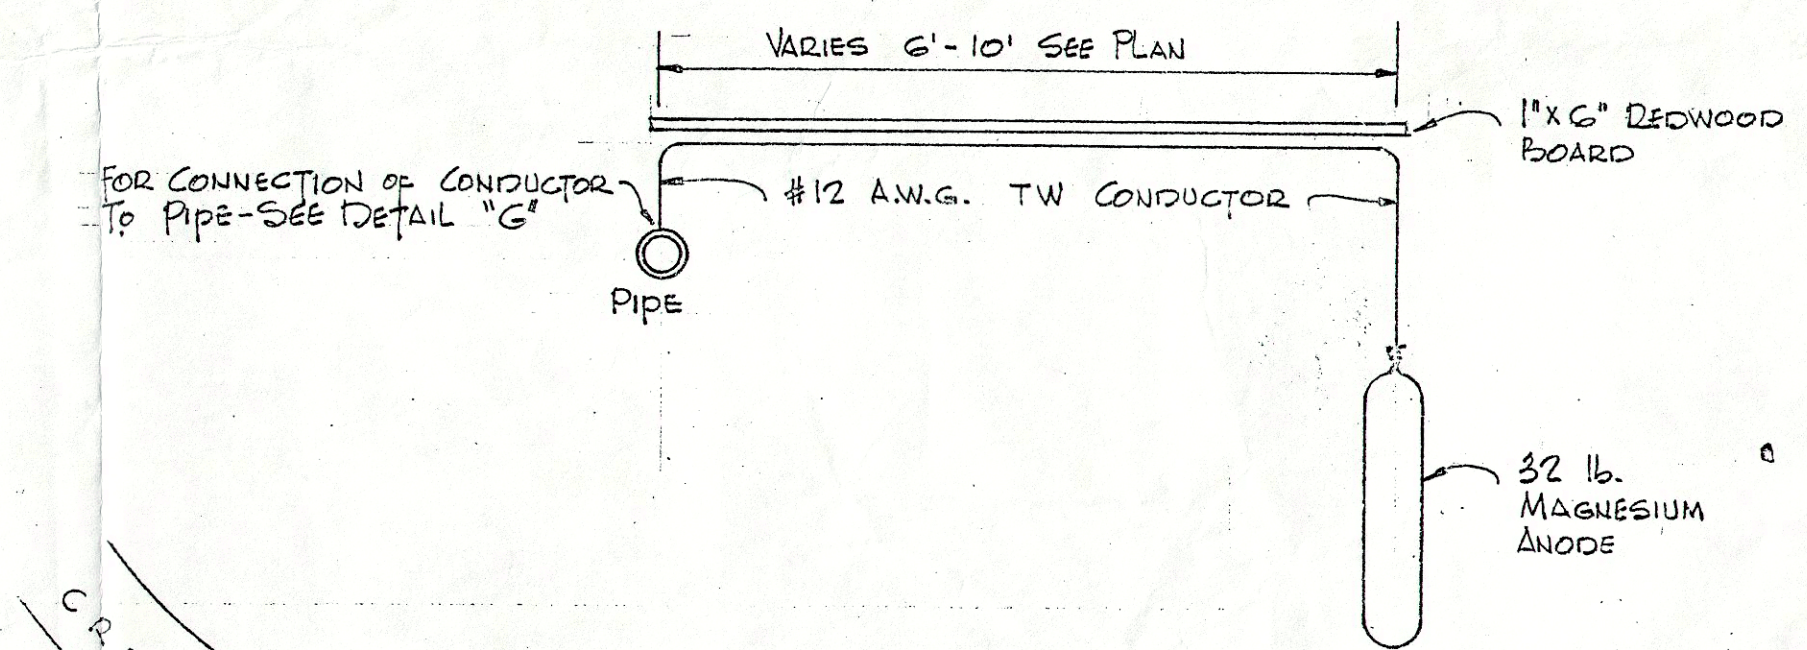


TYPICAL WIRING OF ALL ANODES EXCEPT TEST ANODE
DETAIL "F"
No Scale

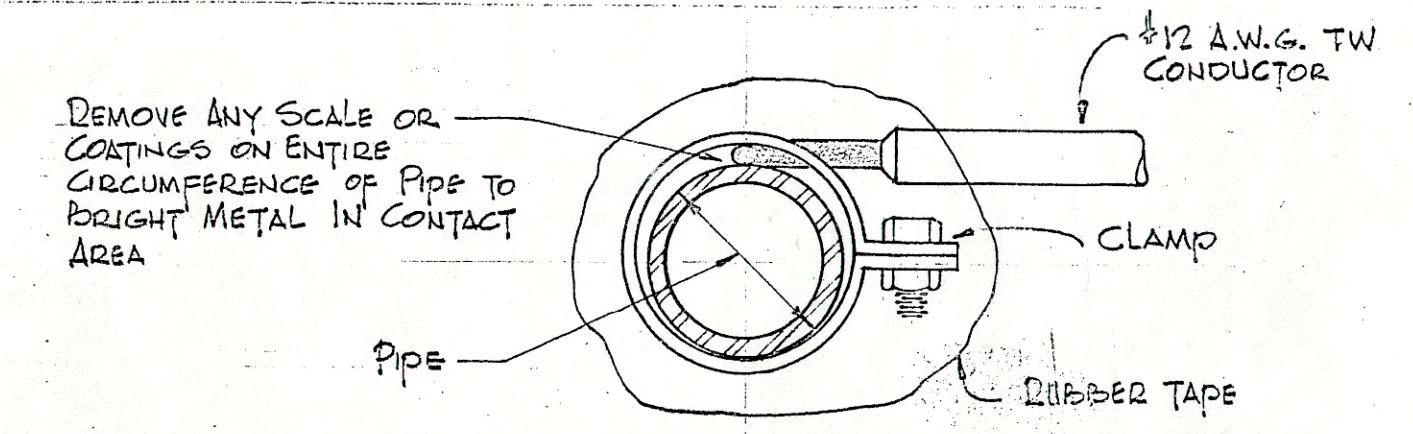


DETAIL "G"
No Scale


- LEGEND**
- ABANDONED WATER LINE
 - EXISTING WATER LINE IN SERVICE
 - ▲ TEST STATION (CATHODIC PROTECTION)
 - ANODE (MAGNESIUM)

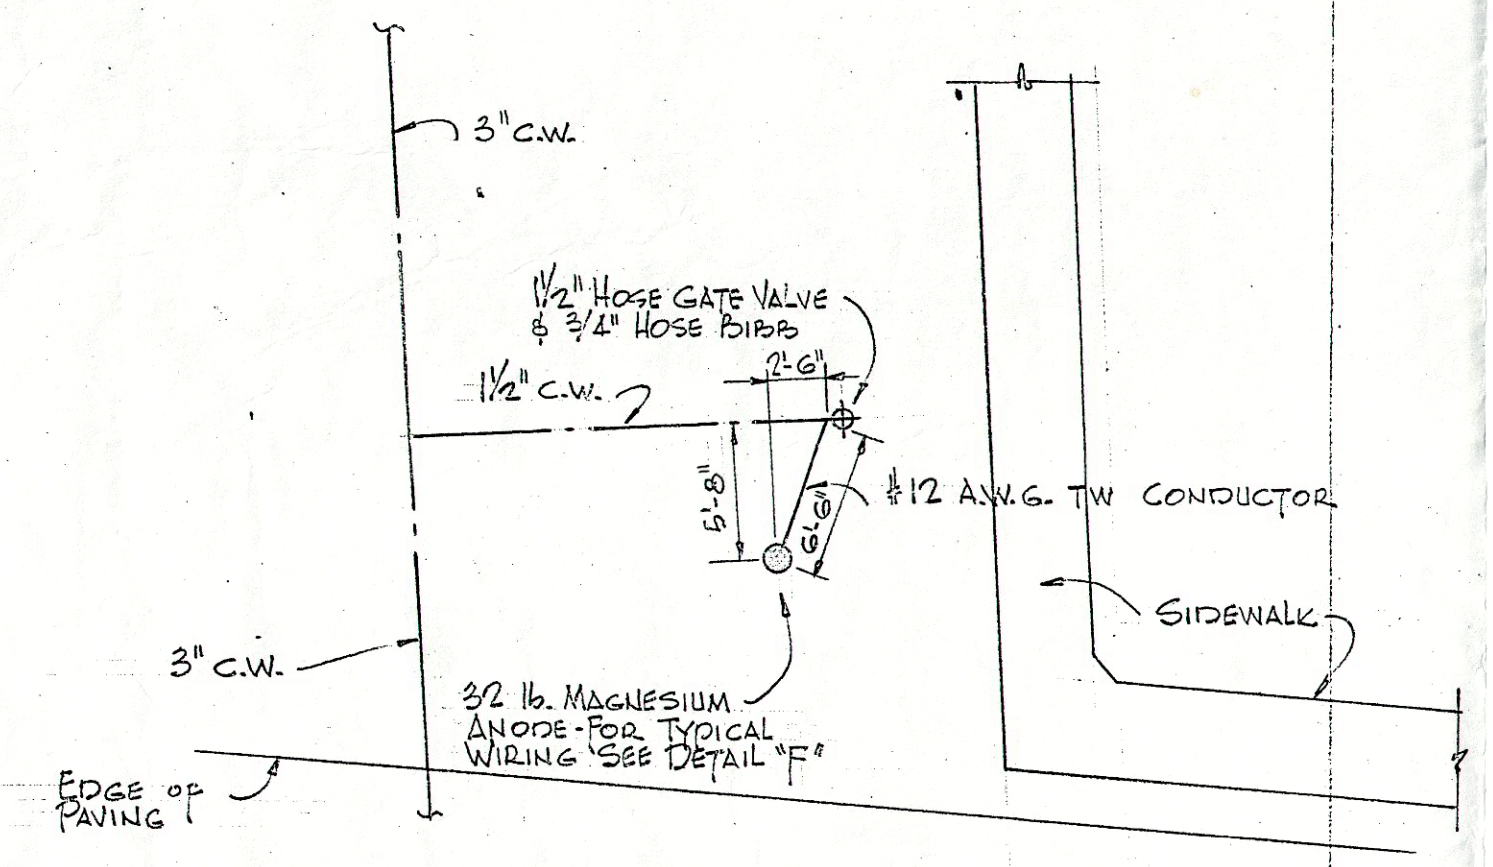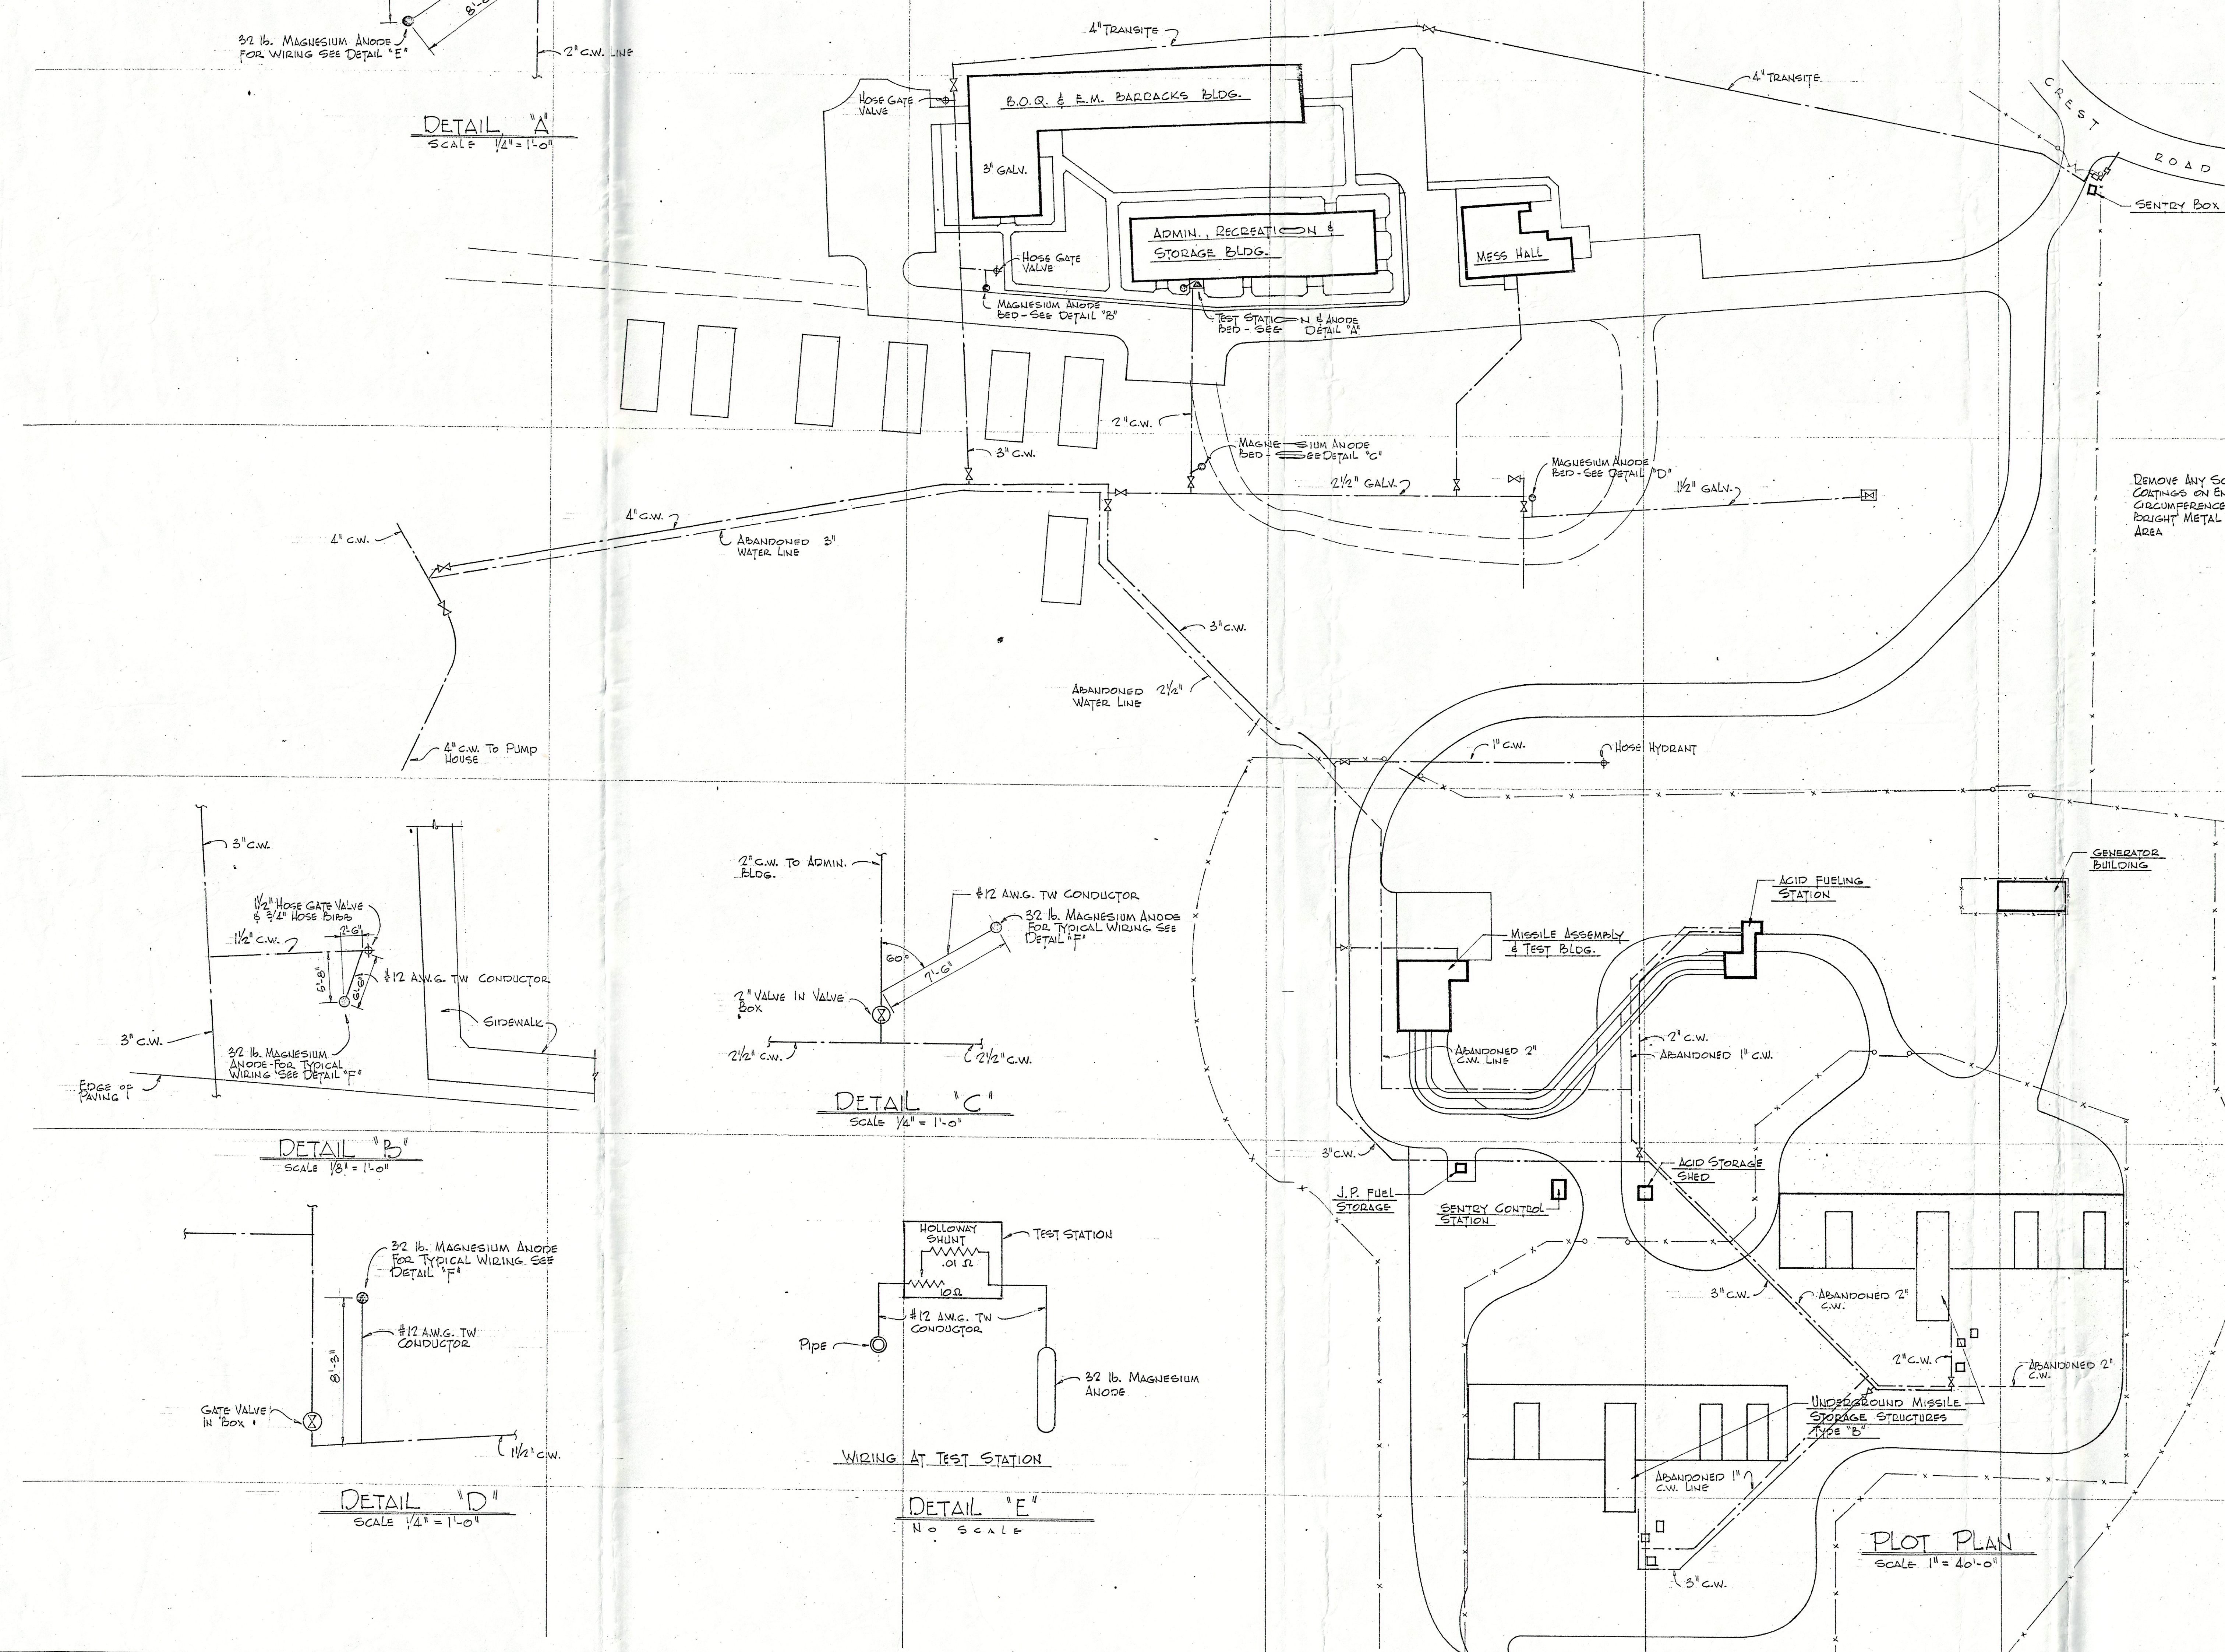


DETAIL "B"
SCALE 1/8" = 1'-0"

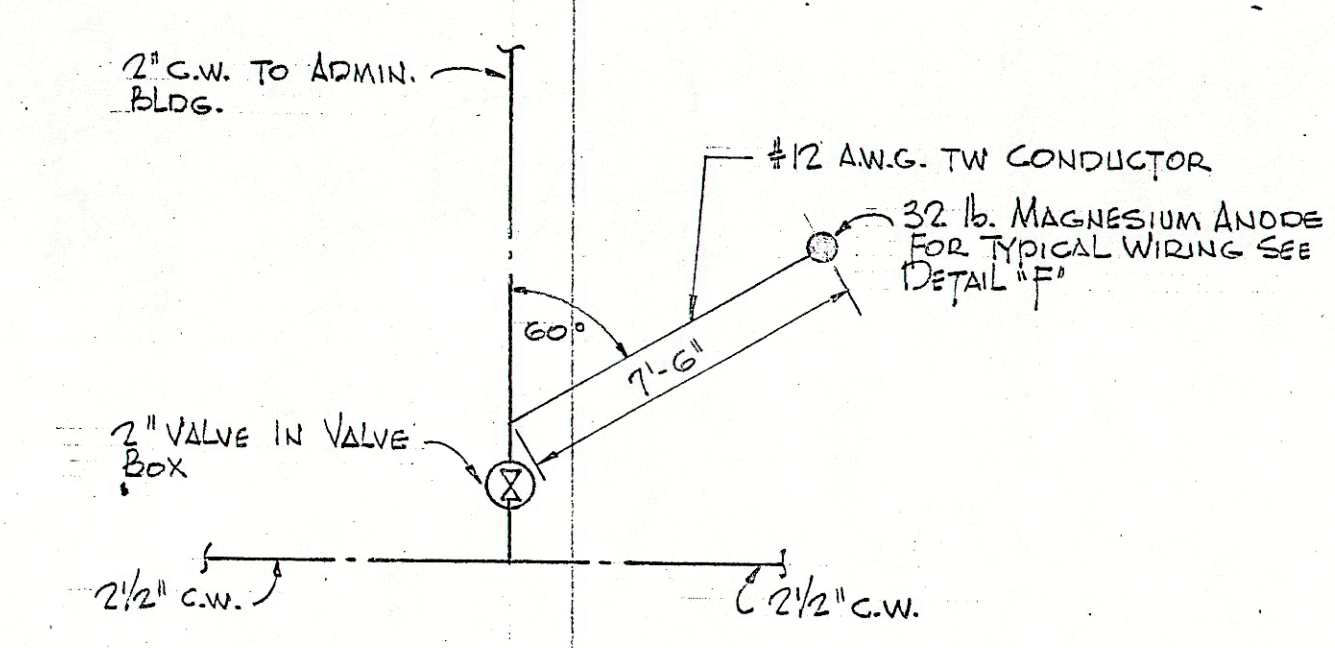

DETAIL "C"
SCALE 1/4" = 1'-0"

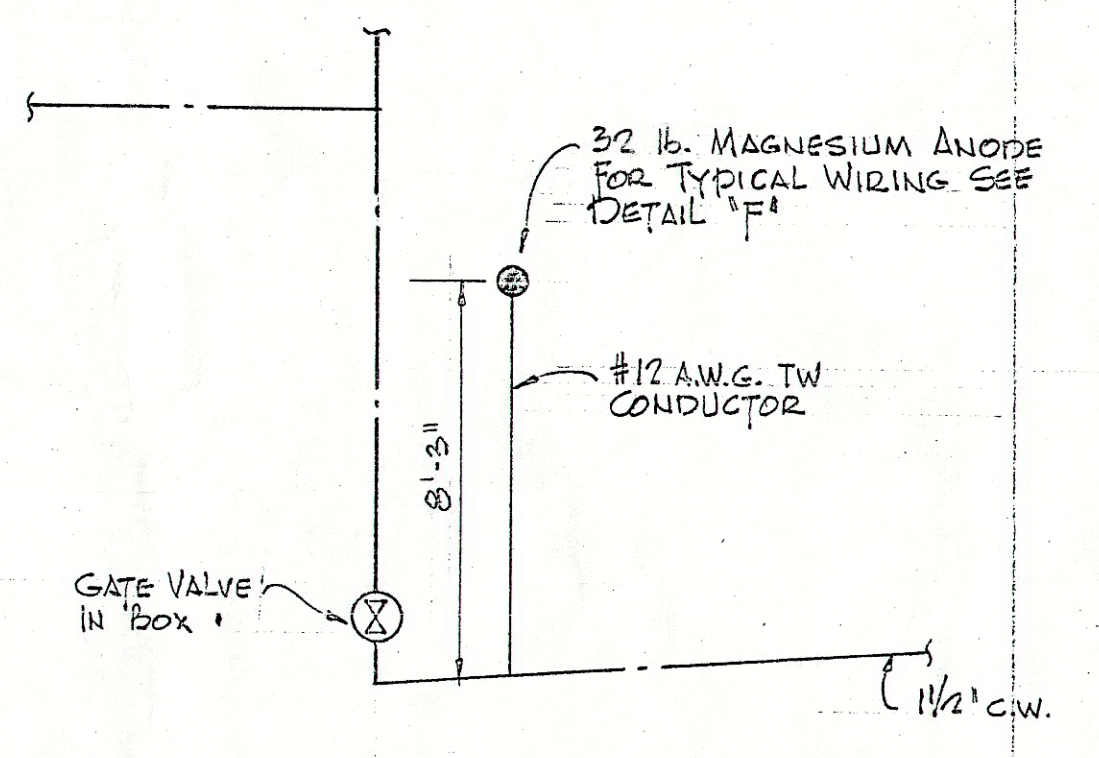

DETAIL "D"
SCALE 1/4" = 1'-0"

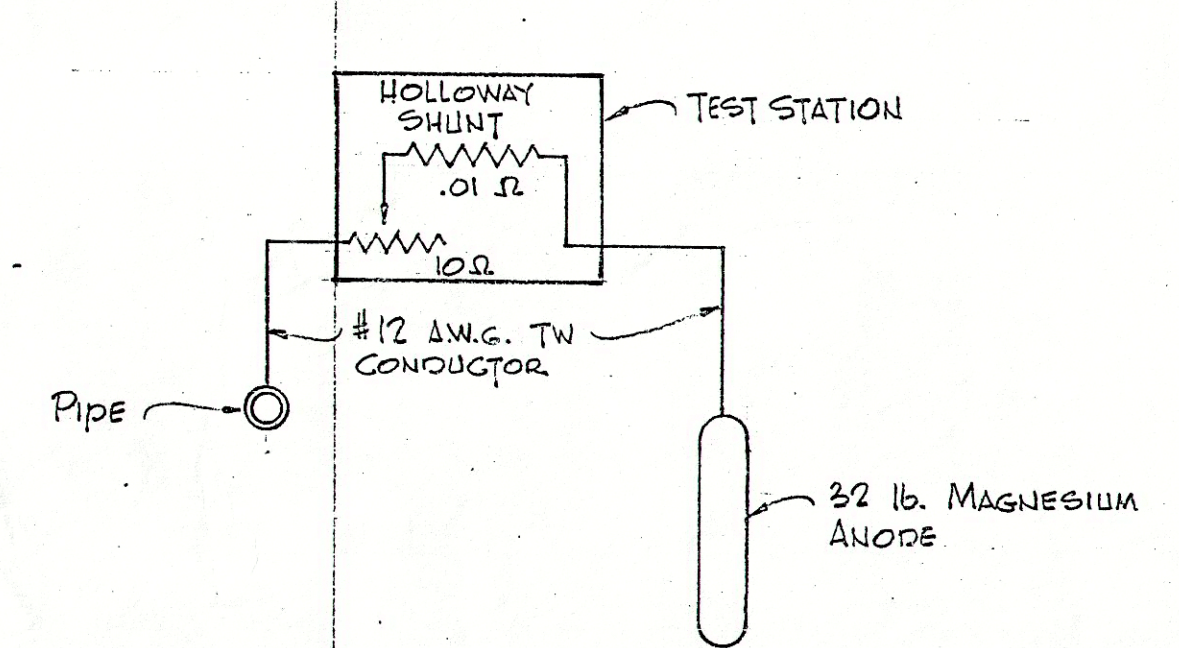

WIRING AT TEST STATION
DETAIL "E"
No Scale

PLOT PLAN
SCALE 1" = 40'-0"

RECORD DRAWING - AS CONSTRUCTED
10 Apr '65

FORT MACARTHUR, CALIFORNIA		
OFFICE OF THE POST ENGINEER		
PLOT PLAN & DETAILS		P.R. NO.
CATHODIC PROTECTION		DRWG. NO.
LA SITE 55		63-106
POINT VICENTE		SHEET
DRAWN BY: MISA		OF 1 SHTS.
CHECKED BY:		2 Apr 63
SCALE: NOTED		