


PLAN CHECK SUBMITAL	9-28-98
PLAN CHECK COMMENTS	1-15-99
2001 CDC UPDATE	11-18-03
C.O.	1-26-05

SCHEDULE		
MEMBER SIZE	PLATE THICKNESS	WELD "Z"
TS6x4x1/2	1"	5/16"
TS6x4x3/16 *	3/4"	1/4"

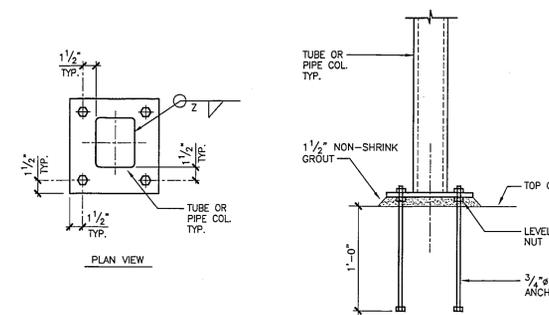


17

TS COL. BASE PLATES

\* AT FOOTING F-6 SEE (10) (S4.1) FOR ADD'L INFO

NOTE: ALL GRADE BEAM REINFORCING SHALL EXTEND THROUGH FOOTINGS/GRADE BEAMS WHERE APPLICABLE. WHERE GRADE BEAMS DO NOT CONTINUE ON OPPOSITE SIDES, EXTEND GRADE BEAM REINFORCING THROUGH FOOTINGS/GRADE BEAMS AS FAR AS POSSIBLE & HOOK.

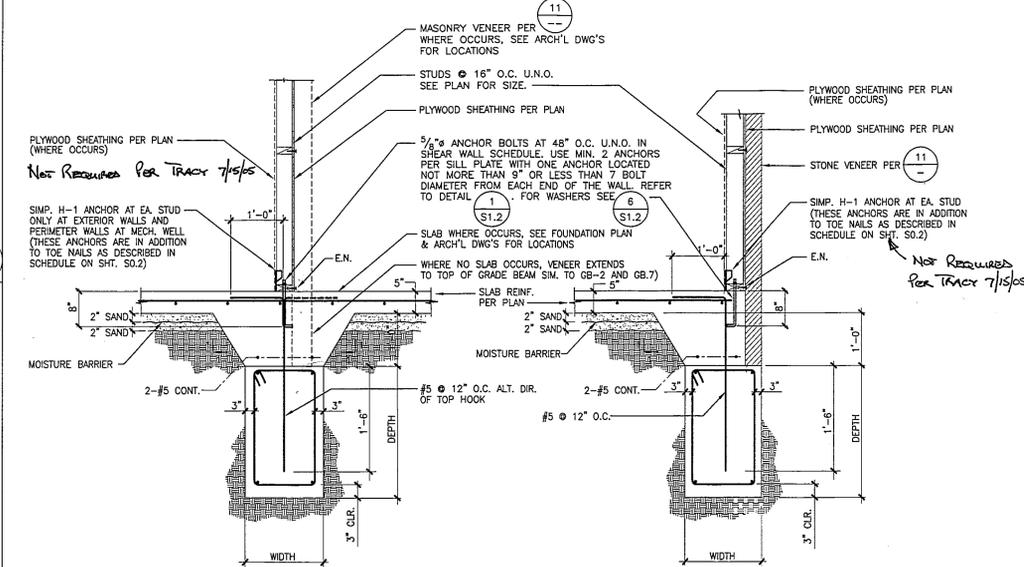

9

INTERIOR WALL GRADE BEAMS

GB-1, GB-3, GB-4, GB-5 AND GB-6 \*\*\*

NOTE: SEE DETAIL 14/S4.1 FOR INFO ON 'GB-8'


\* NO STUD WALL OCCURS AT GB-1  
\*\* PORTION OF 'GB-4' IS AT EXTERIOR WALL  
\*\*\* 'GB-6' IS AT EXTERIOR WALL

2B

EXTERIOR WALL GRADE BEAMS


GB-2 AND GB-7

2A

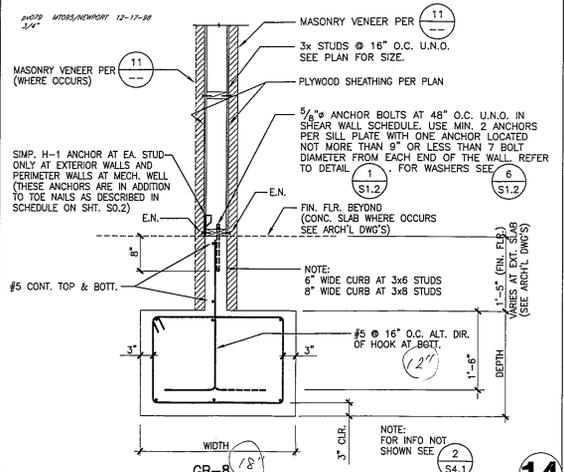

18

MASONRY VENEER PER PLAN

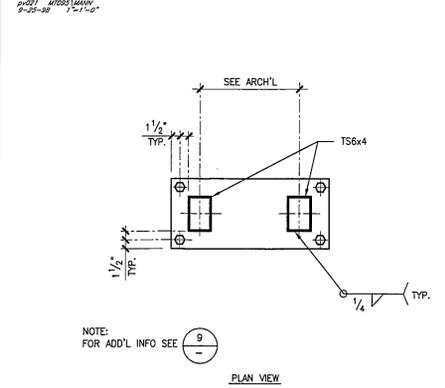


14

COMBINED TS COL. BASE PLATE


INTERIOR/EXTERIOR WALL FOOTING/GRADE BEAM

2

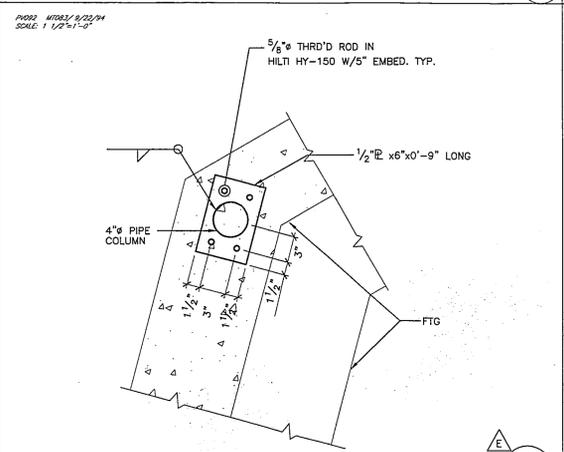


19

5/8\"/>

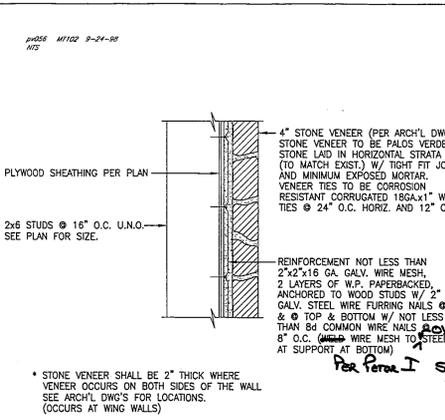


15

ATTACHMENT OF VENEER TO STUD WALL

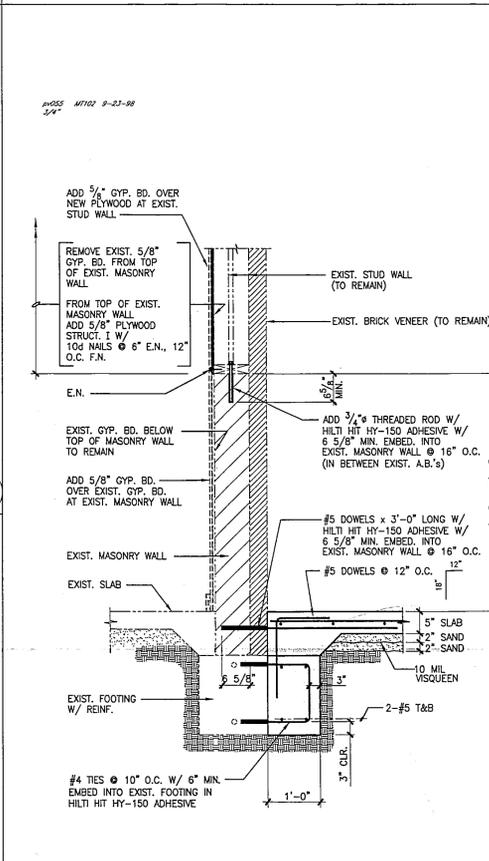


12

FOOTING DETAIL

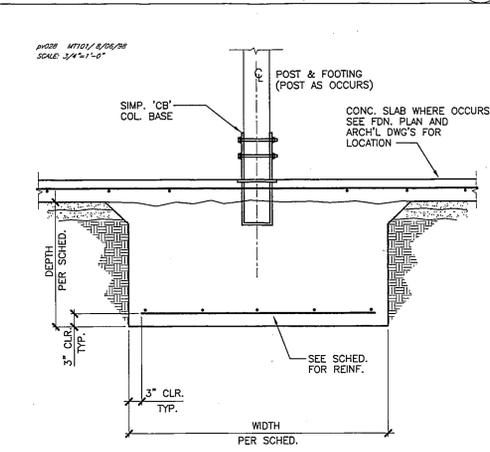


3

WOOD POST FOUNDATION

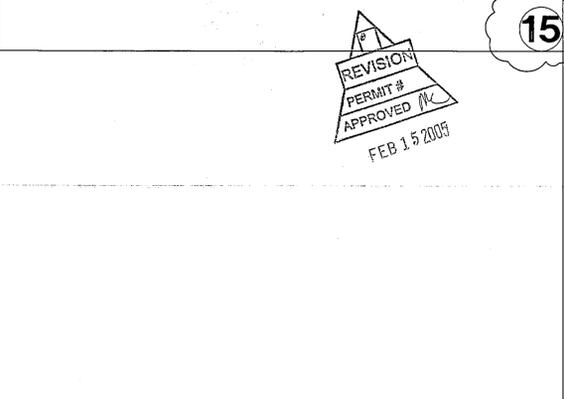

20

STUD WALL

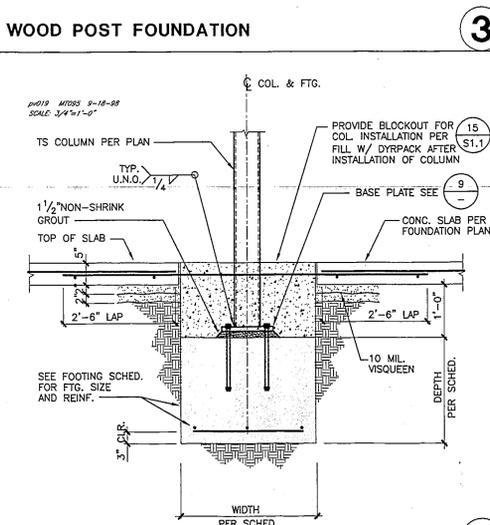

4

TUBE STEEL COL. FOUNDATION

REVISION PERMIT # APPROVED FEB 15 2005

RON YEO, FAIA ARCHITECT, INC.  
500 JASMINA AVENUE, CORONA DEL MAR  
CALIFORNIA 92625 P:949-644-8111 F:949-644-0449  
PATRICK MARR, AIA, PE, ASSOCIATE ARCHITECT

ABS Consulting  
ECC Structural Engineers Division  
100 Commercial Blvd., Suite 500  
Corona, CA 92625  
Phone (714) 794-4242  
Fax (714) 794-4272

POINT VICENTE INTERPRETIVE CENTER EXPANSION  
Verdes Drive West  
Petaluma, CA

FOUNDATION DETAILS

DRAWN DW  
CHECKED SA  
DATE  
SCALE AS NOTED  
JOB NO. 2653401  
SHEET

S4.1

OF SHEETS

Ron Yeo, Architect Inc. expressly reserves its common law copyright for these plans. These plans are to be used only for the project and site named herein. No other use, reproduction, or distribution is permitted without the written permission and consent of Ron Yeo, Architect Inc.

THESE DRAWINGS DO NOT CONTAIN THE NECESSARY COMPONENTS FOR CONSTRUCTION SAFETY