


R.P.V. Park
Site Grading Plan Sheet A4R & 4

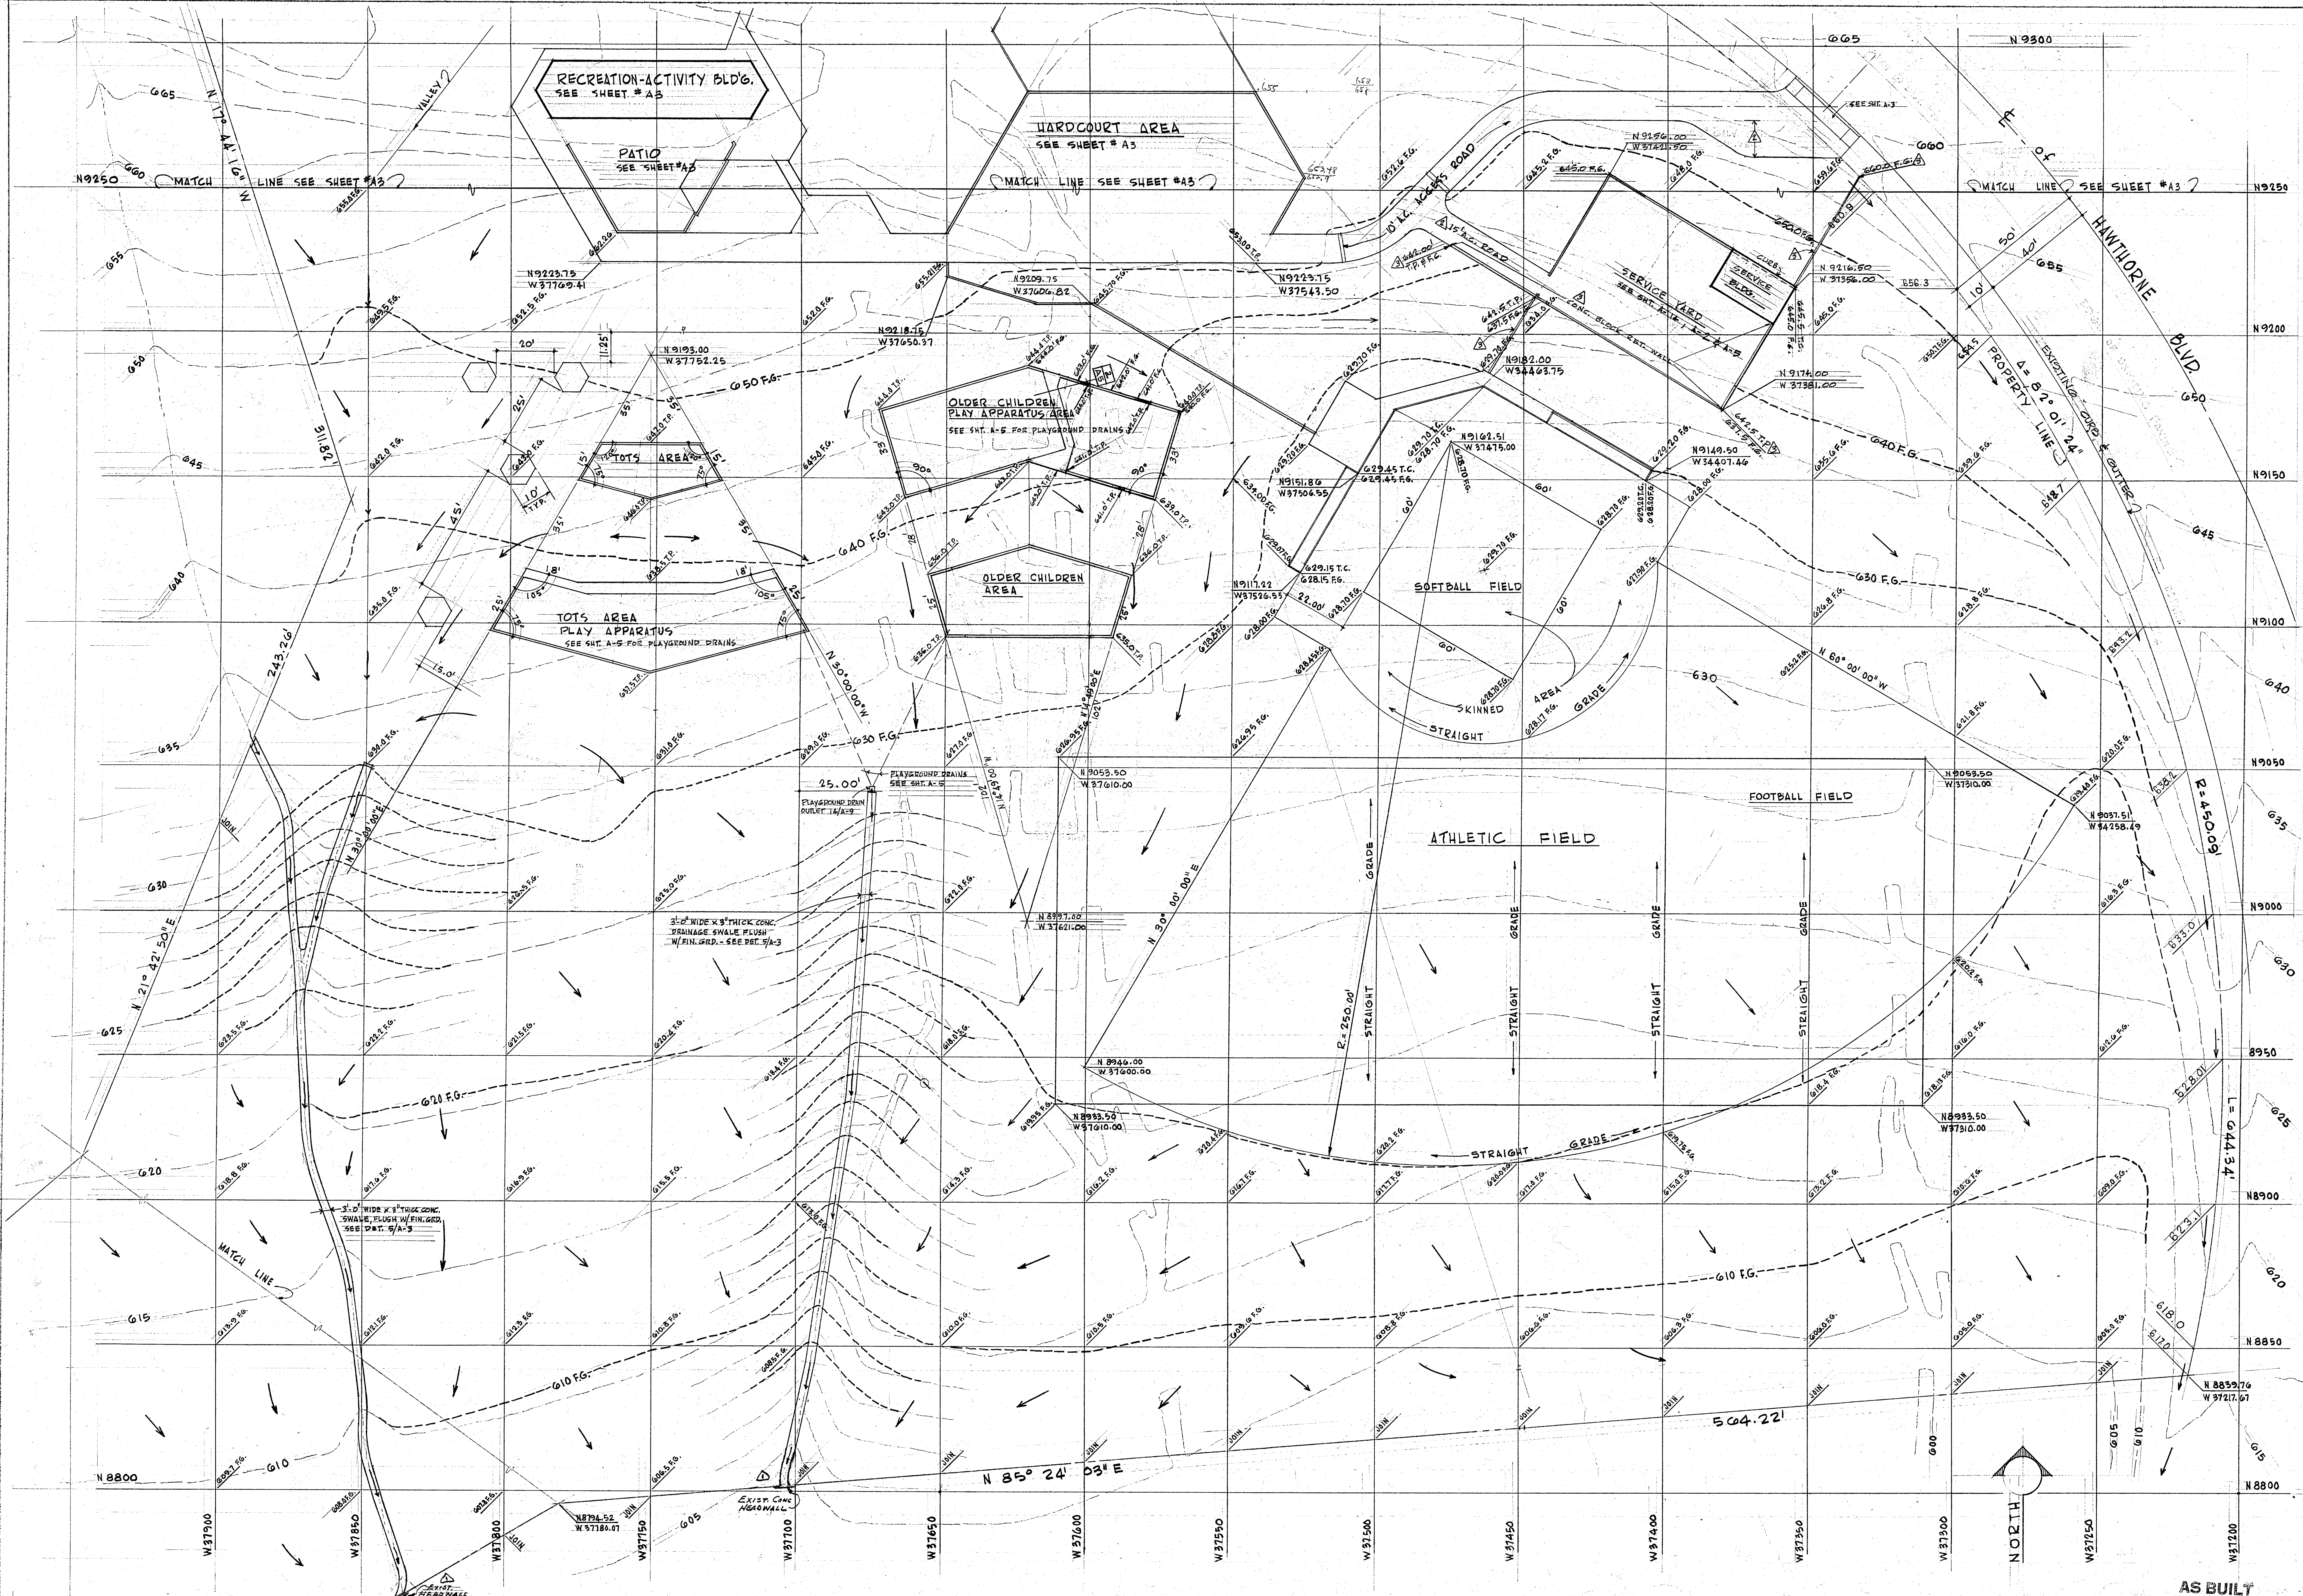

J. PAUL ROBINSON & ASSOC. CIVIL ENGINEER LONG BEACH, CALIFORNIA		EDWIN H. RIPPERDAN ARCHITECT 5610 LONG BEACH BLVD. • LONG BEACH • CALIF. 90801		REVISIONS 1. 10-24-68 DRAINAGE SWALE 2. 11-19-68 CO. #8 3. 12-14-68 SUPP. AGENT #1		ACTIVITY BUILDING & GENERAL DEVELOPMENT FOR THE COUNTY OF LOS ANGELES PALOS VERDES COUNTY PARK 30359 S. HAWTHORNE BLVD. PALOS VERDES • CALIFORNIA		SITE GRADING PLAN PART 2 AS-BUILT CORRECTIONS: 2/27/70 SCALE: 1" = 20'-0" DRAWN BY: NG CHECKED BY: EWR, JPR DATE: 6-8-64 REVISED: 8-24-68 ARCH. JOB #1: 628 SHEET 14		CARPROJ. NO. 8859-02 SPEC. NO. 2379 A4R	
---	--	--	--	---	--	--	--	--	--	---	--