
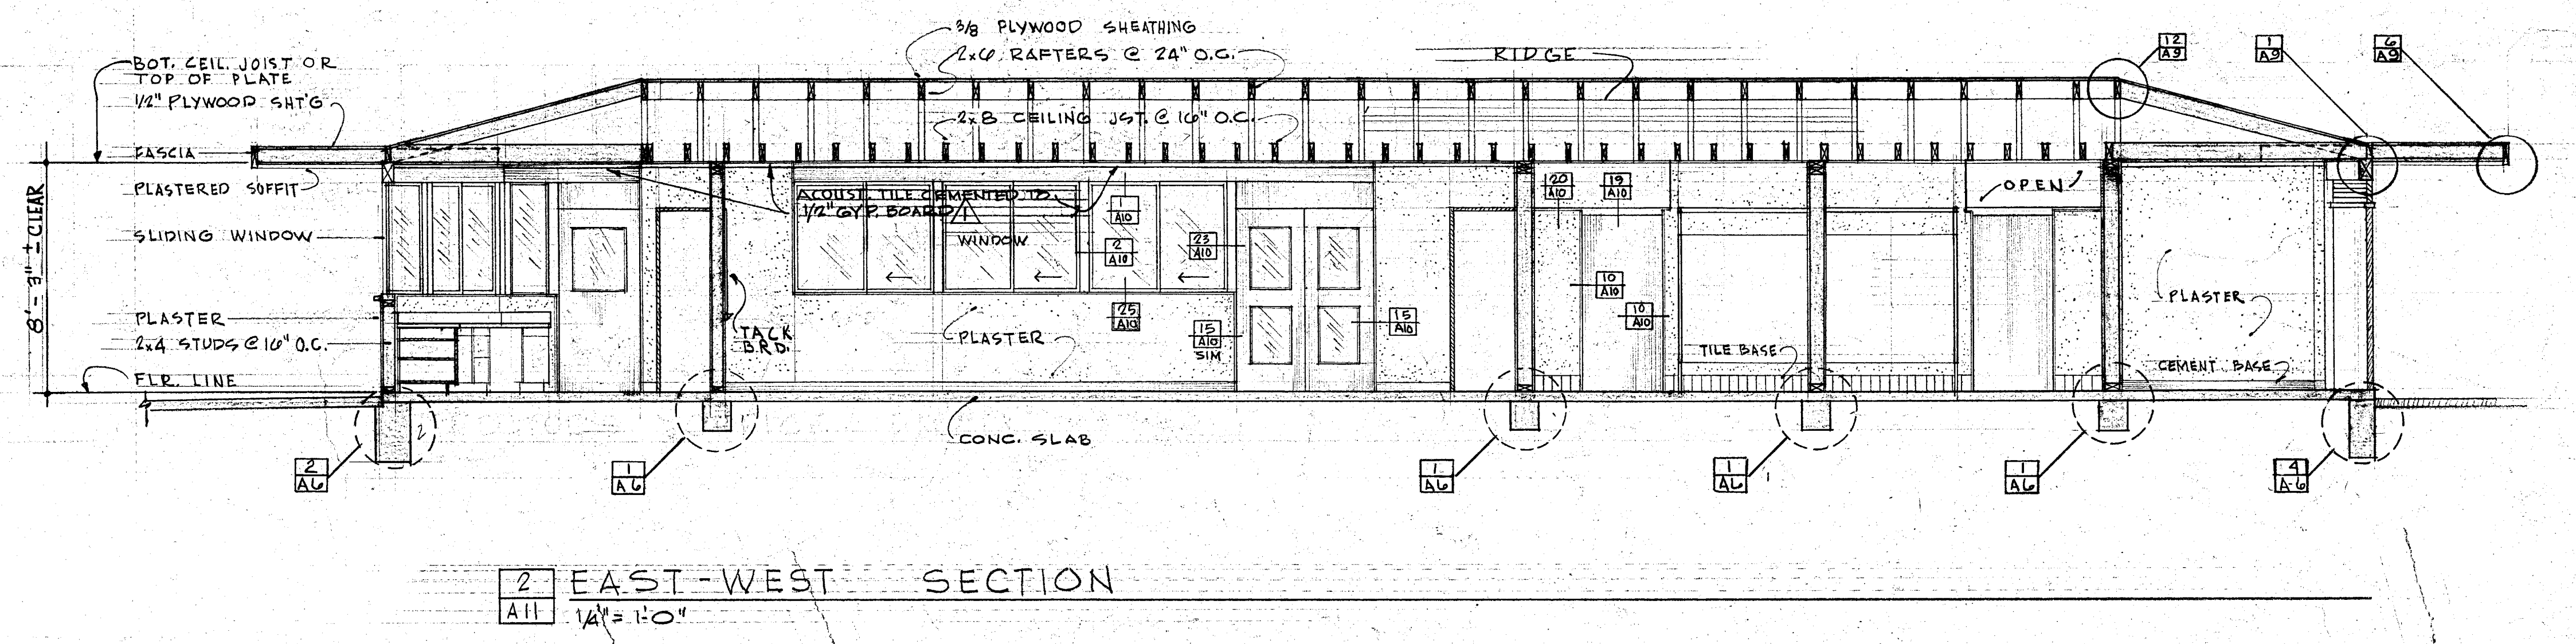
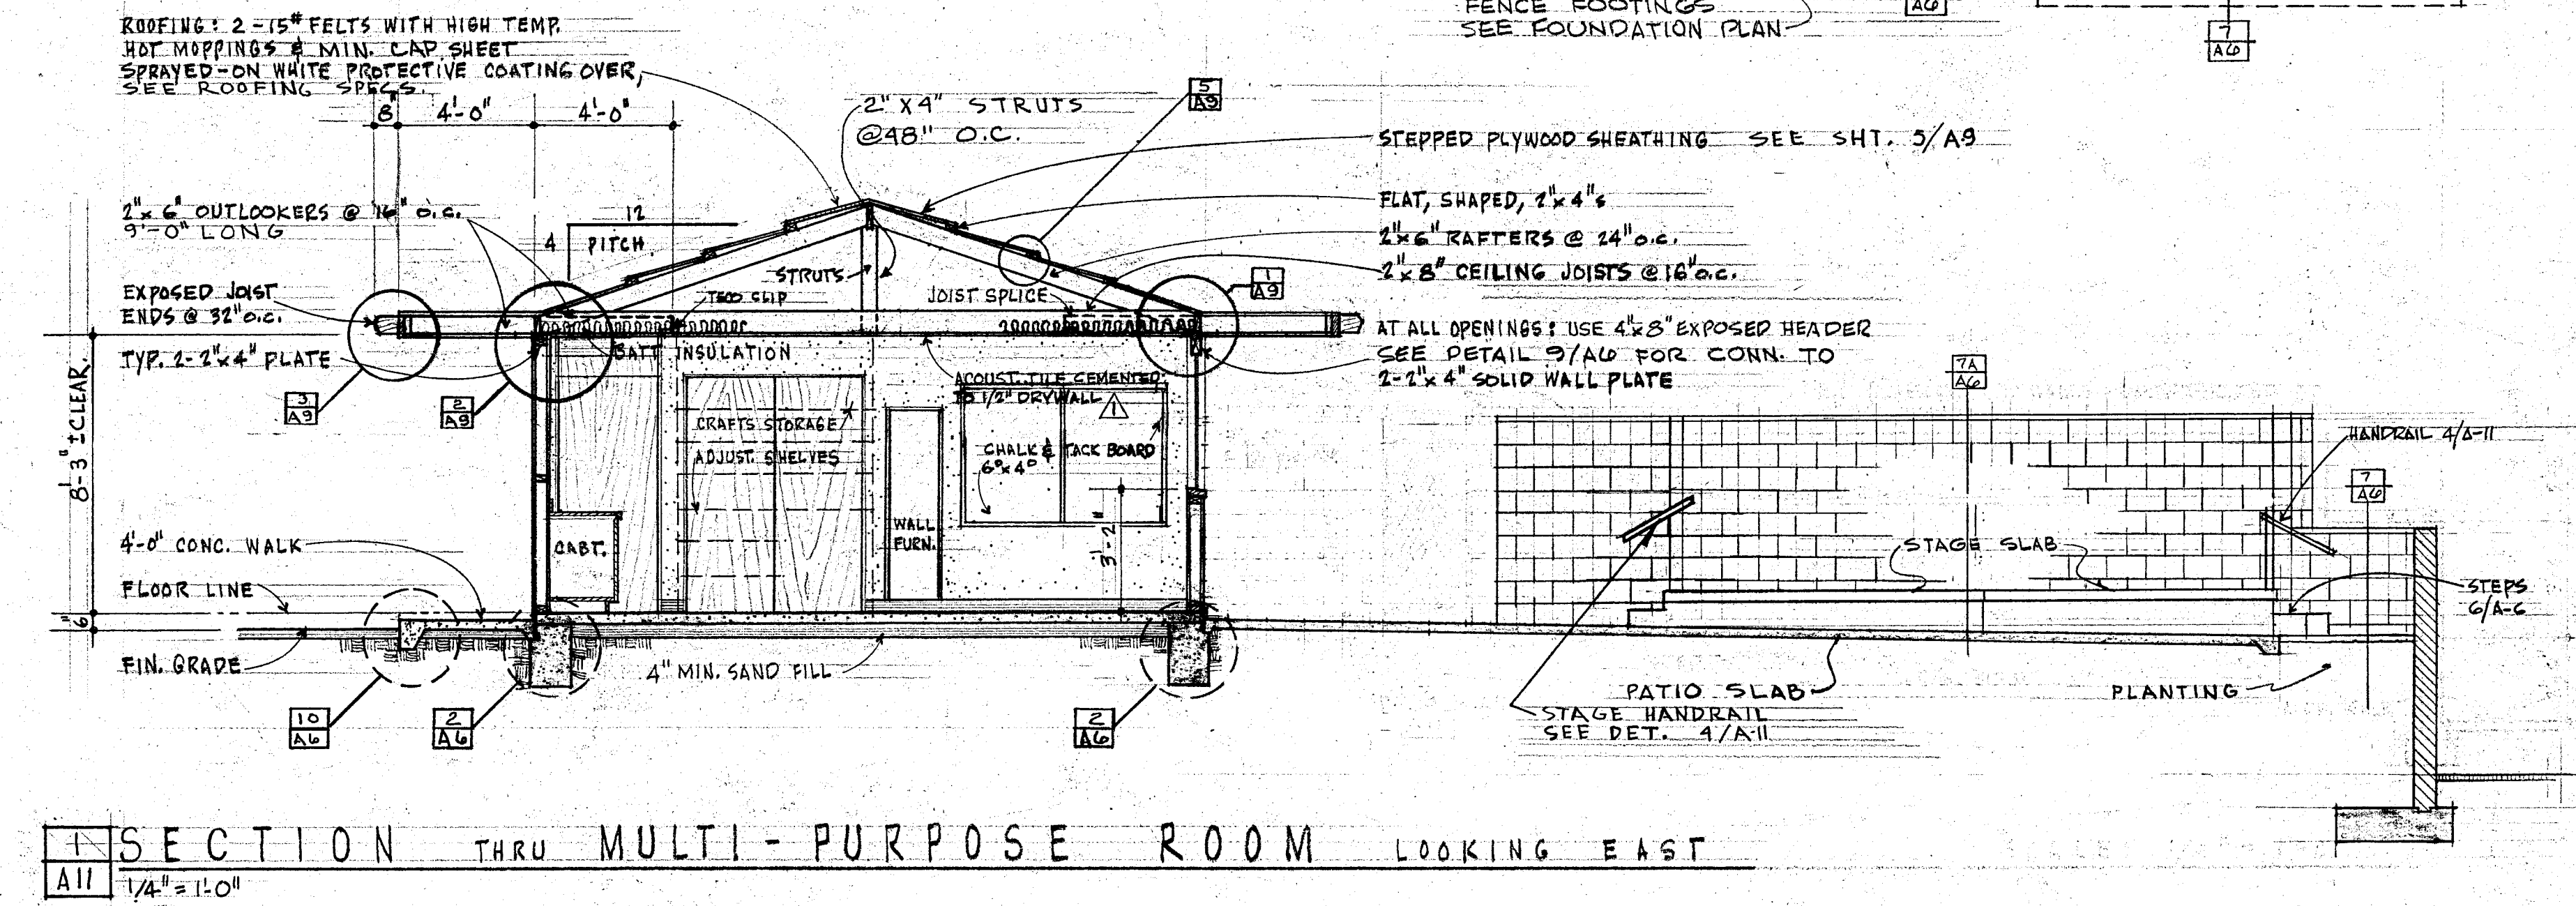
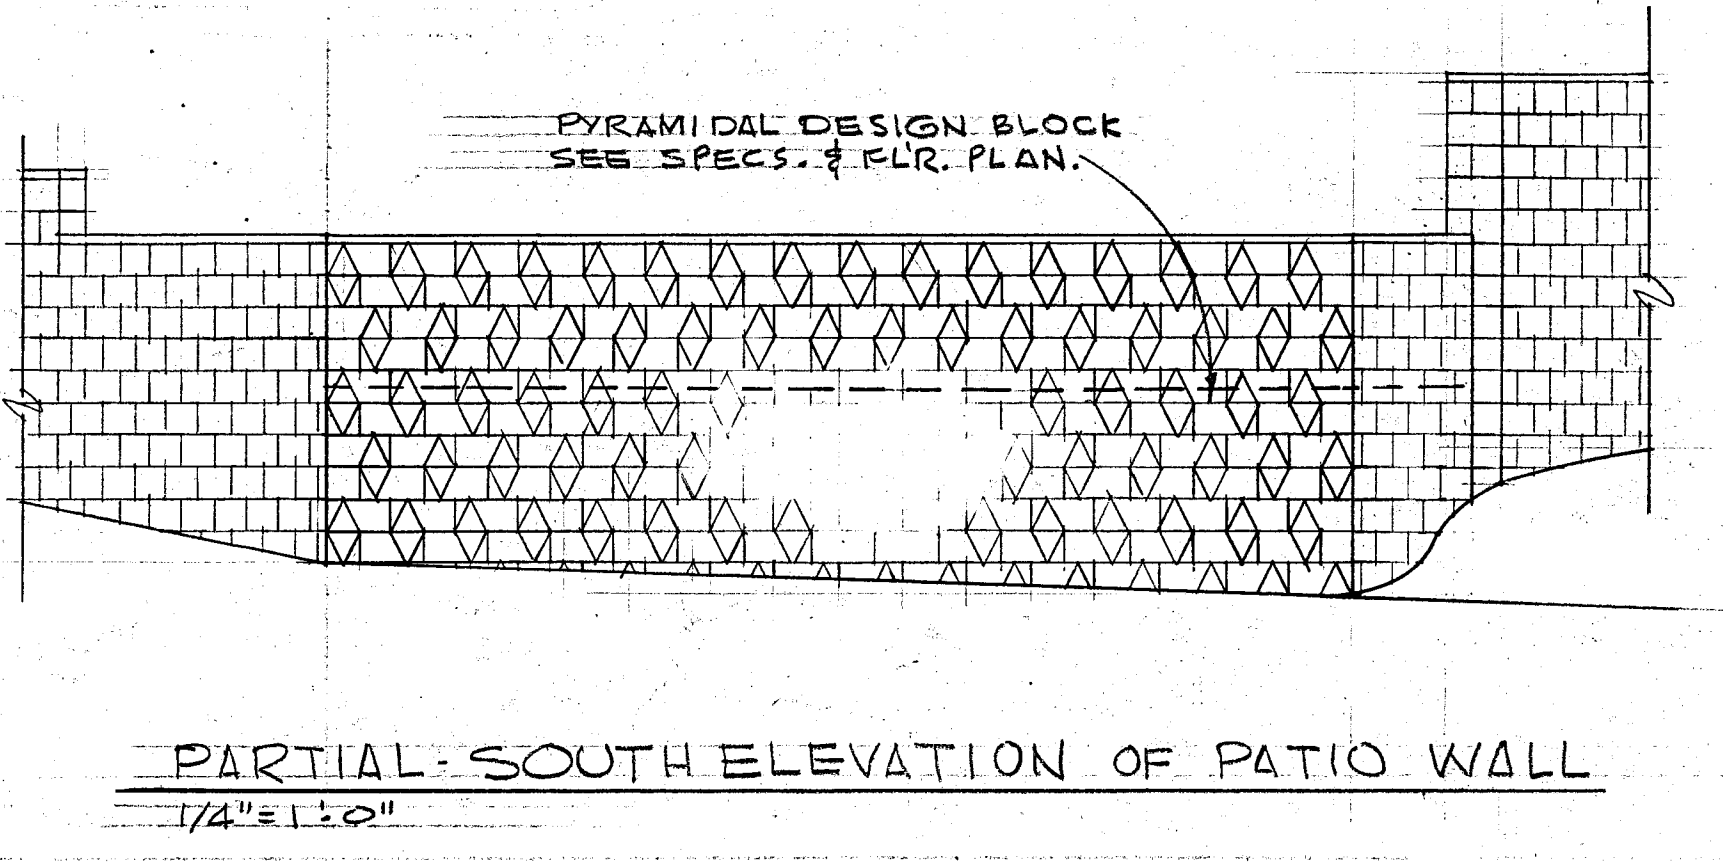
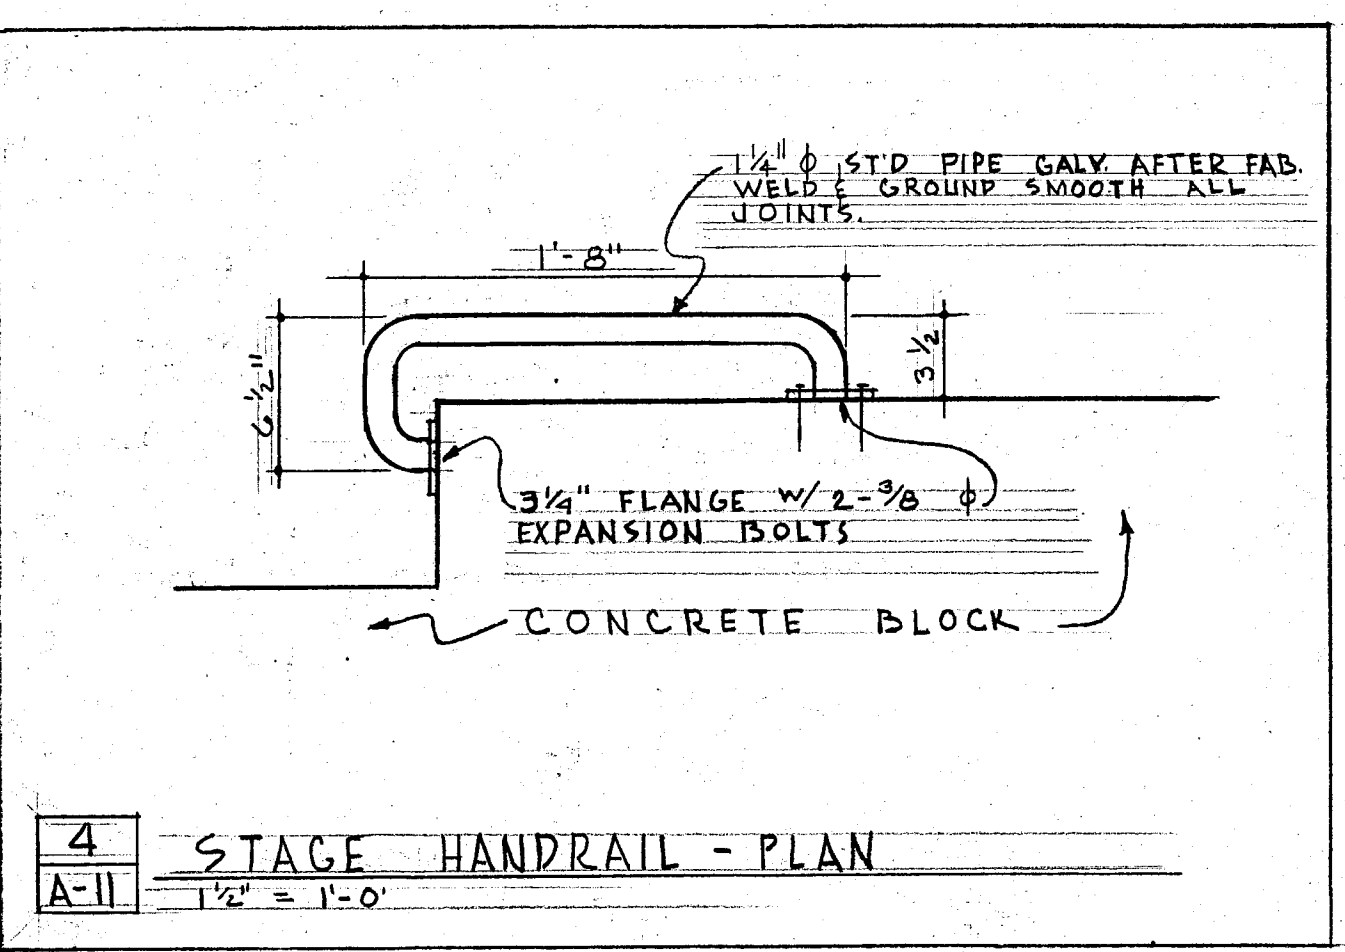
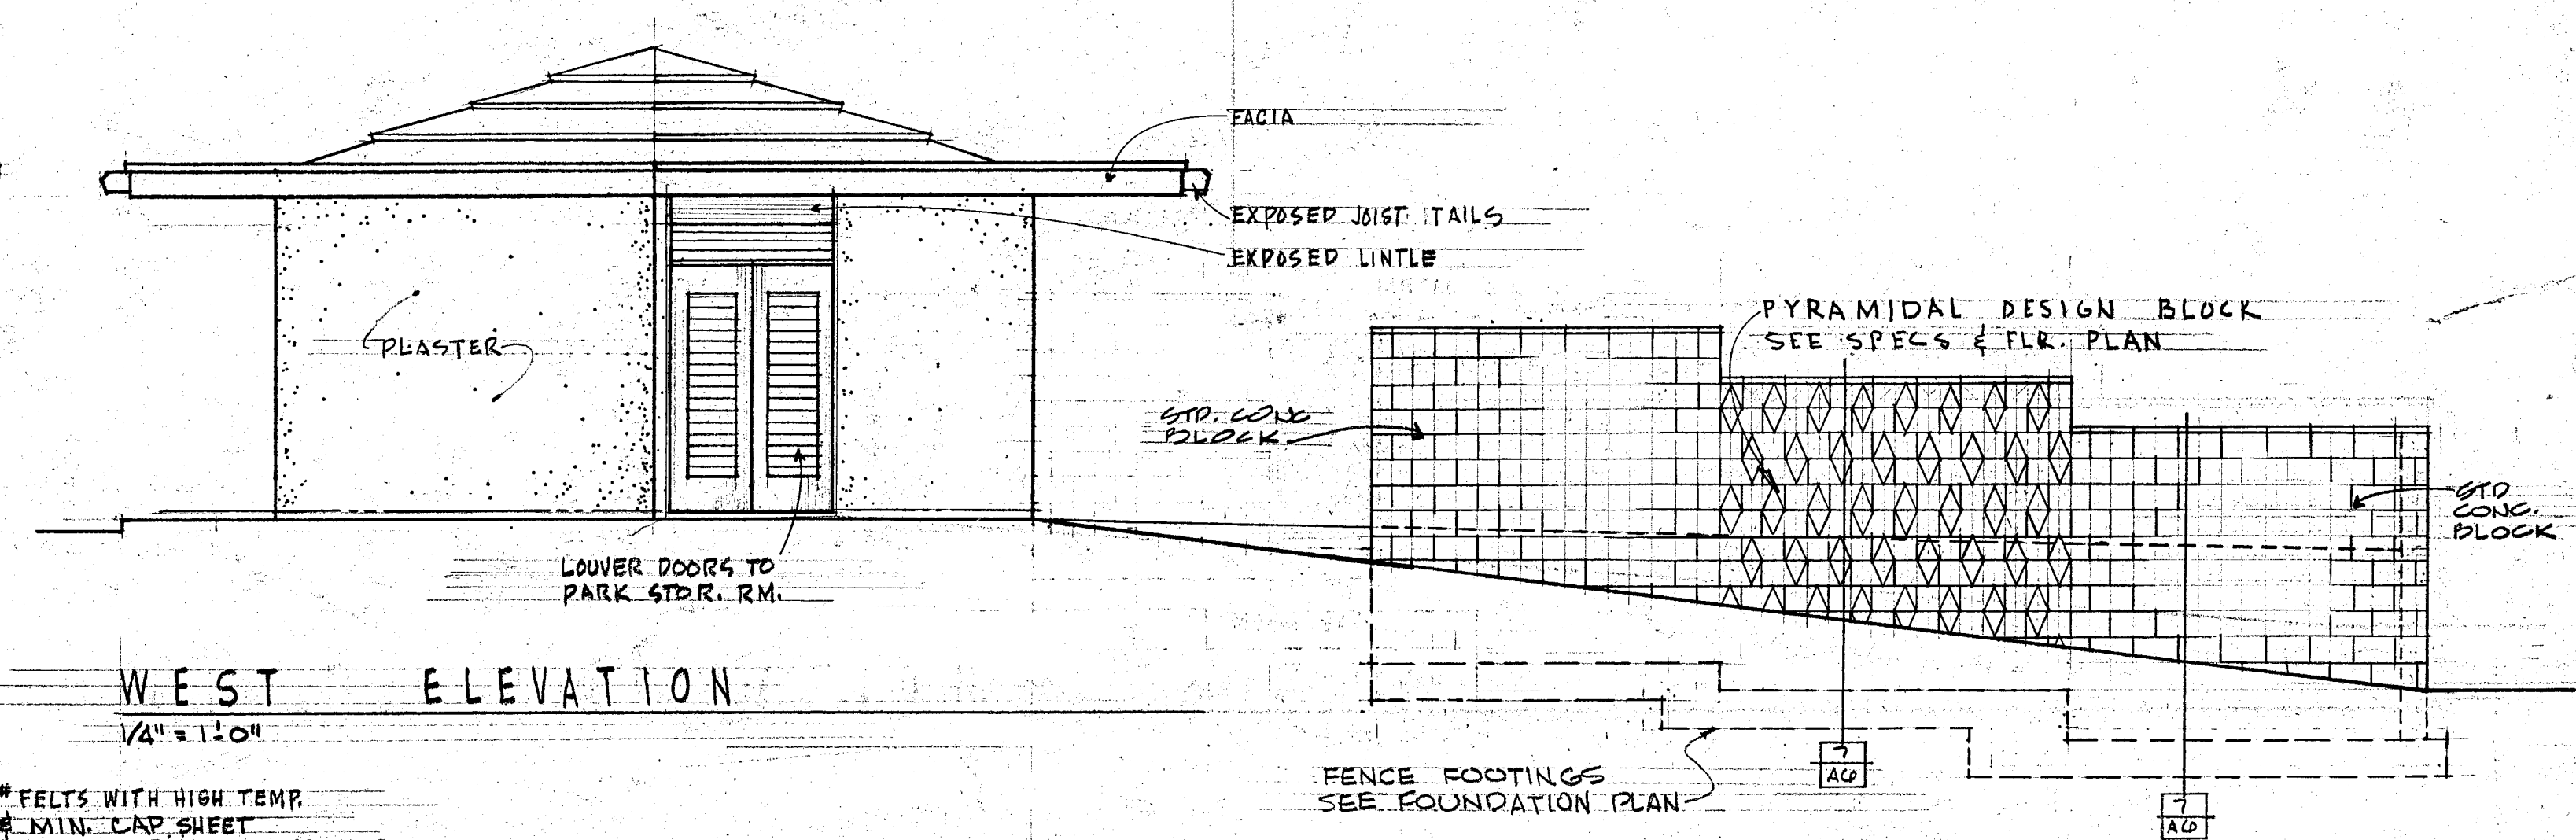
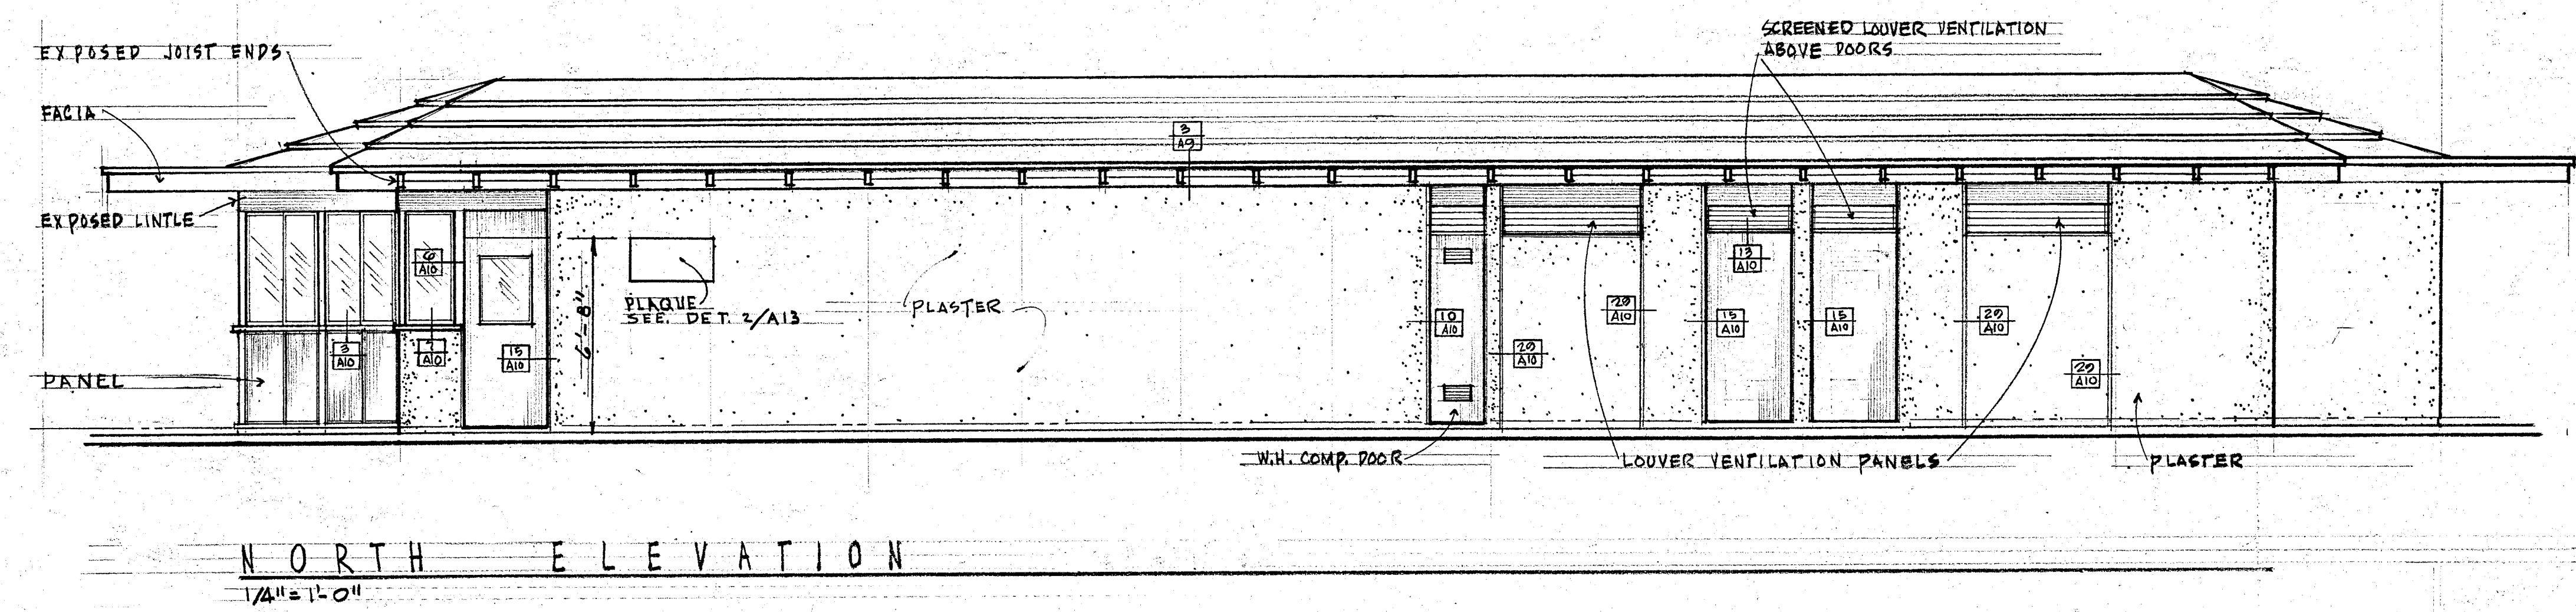
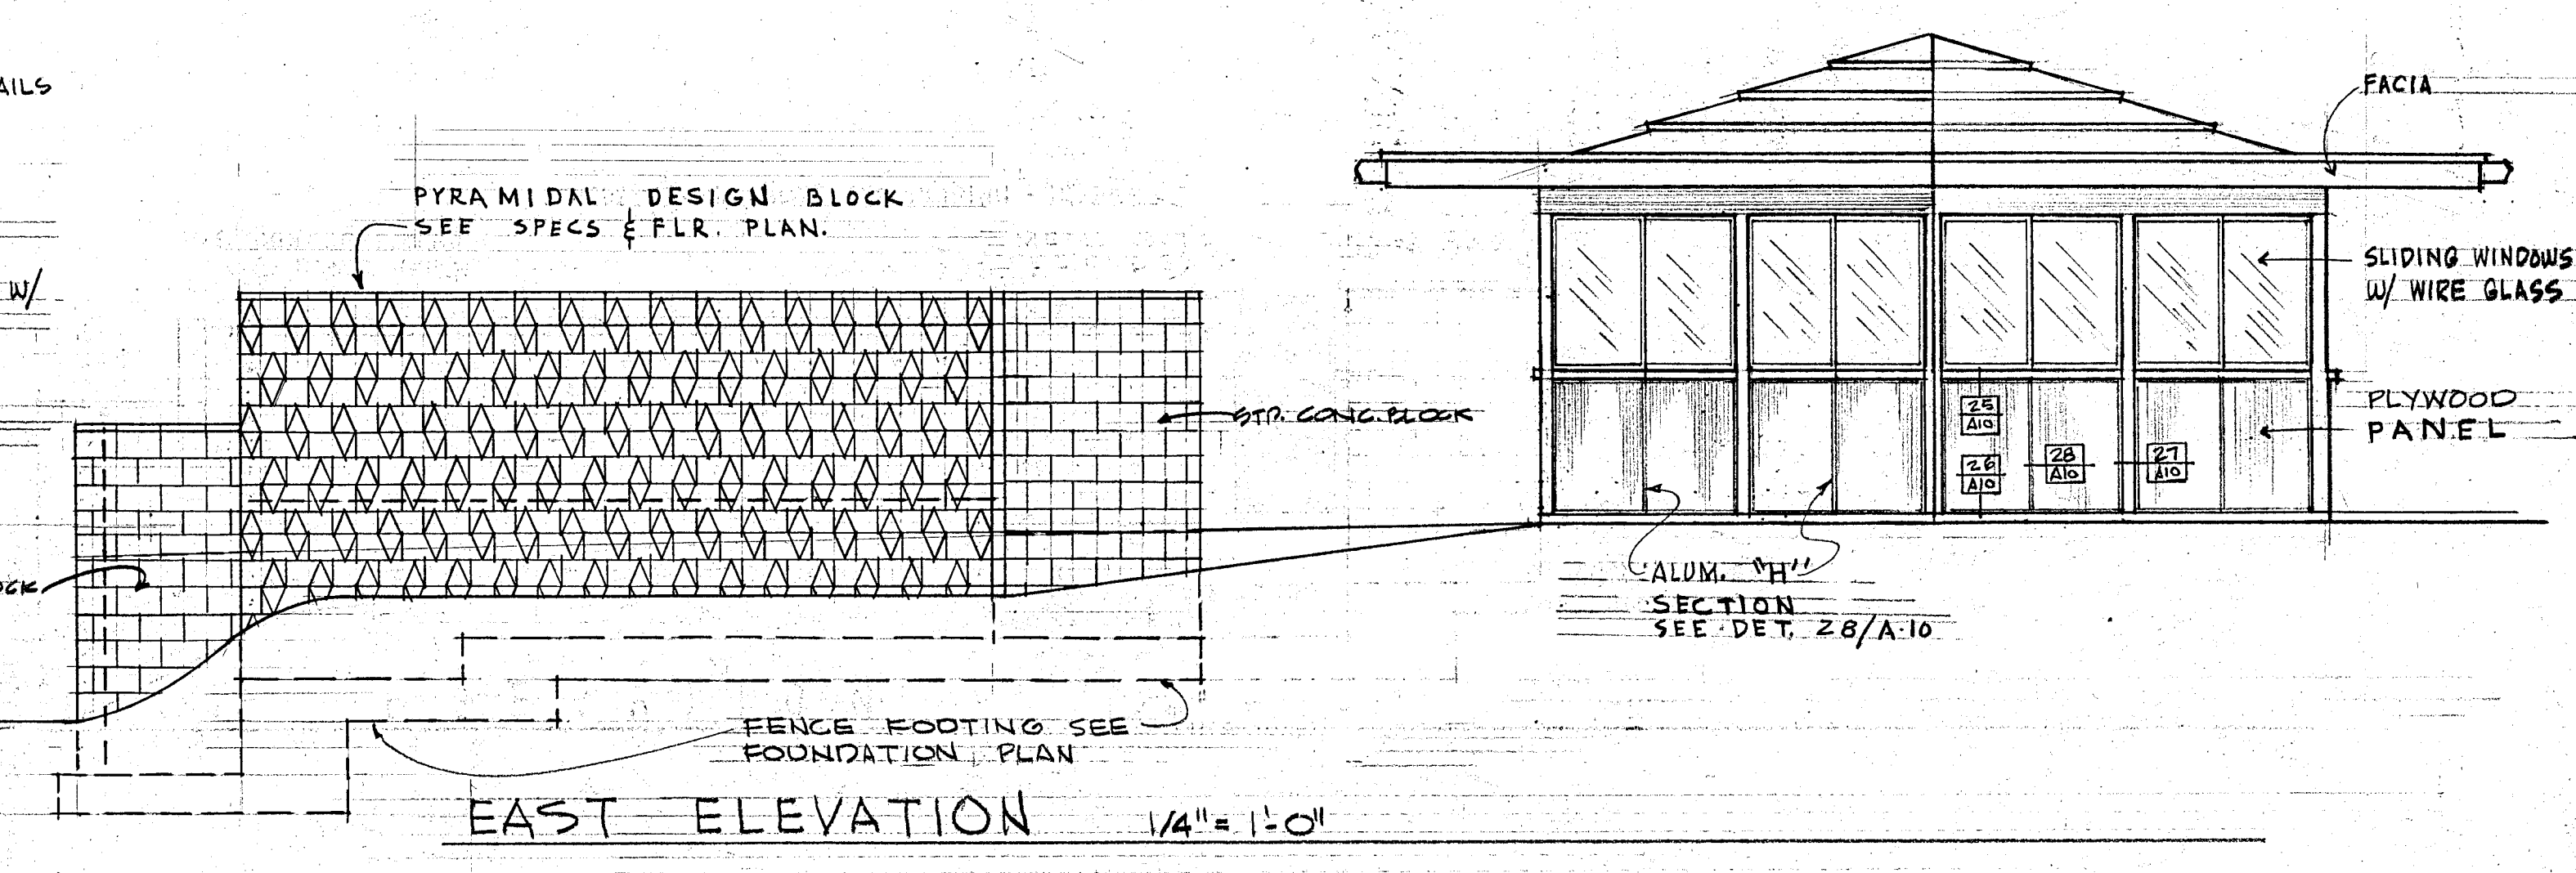


RPV Pack
Elevations & Sections Sheet A11 of 14

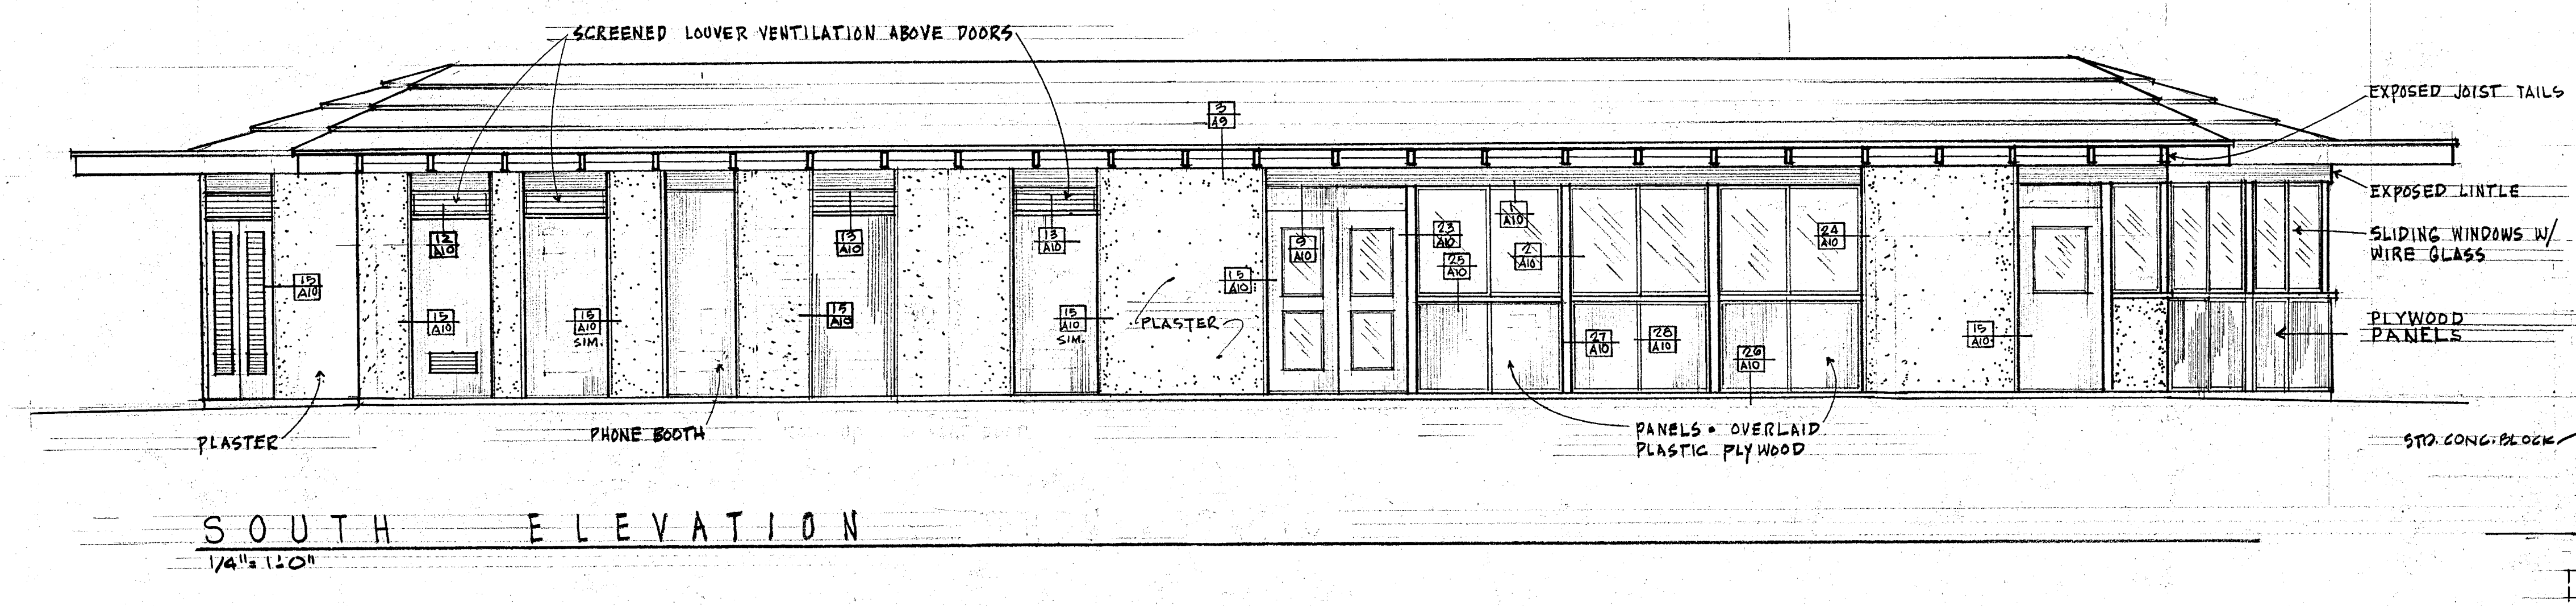

EDWIN H. RIPPERDAN
ARCHITECT
3610 LONG BEACH BLVD. LONG BEACH, CALIF. 424-6701

REVISIONS
C-2301

ACTIVITY BUILDING & GENERAL DEVELOPMENT FOR THE COUNTY OF LOS ANGELES
PALOS VERDES COUNTY PARK
30359 S. HAWTHORNE BLVD. PALOS VERDES • CALIFORNIA

ELEVATIONS & SECTIONS
AS-BUILT CORRECTIONS 2/27/70 SCALE: 1/4" = 1'-0" DRAWN BY: ER CHECKED BY: EHR DATE: 6-8-64 REVISED: 7-1-68 7-27-68
CAR. PROJ. NO. 2559-21 SHEET SPEC. NO. 2399 ARCH. JOB NO. 028 OF 14