



NOTES:


- SEWER SHALL BE WEDGE-LOCK, VITREOUS CLAY PIPE, CONFORMING TO "ASTM. SPECS. C-13", OF LATEST REVISION. SIZE AS NOTED ON PLAN.
- DRAIN SHALL BE 16 GAUGE GALV. CORRUGATED METAL PIPE, 24" DIA., CONFORMING TO "AREA. SPECS. FOR CORRUGATED METAL PIPE", OF LATEST REVISION.
- DRAIN SHALL BE INSTALLED ON "ORDINARY" BEDDING, WITH EARTH CAREFULLY FORMED TO FIT THE LOWER PIPE SECTION, SEE DETAIL 1/M3.
- SEE SPECS. FOR INSTALLATION AND BACKFILL FOR SEWER AND DRAIN.
- PROVIDE A MIN. OF 18" COVER OVER DRAIN.

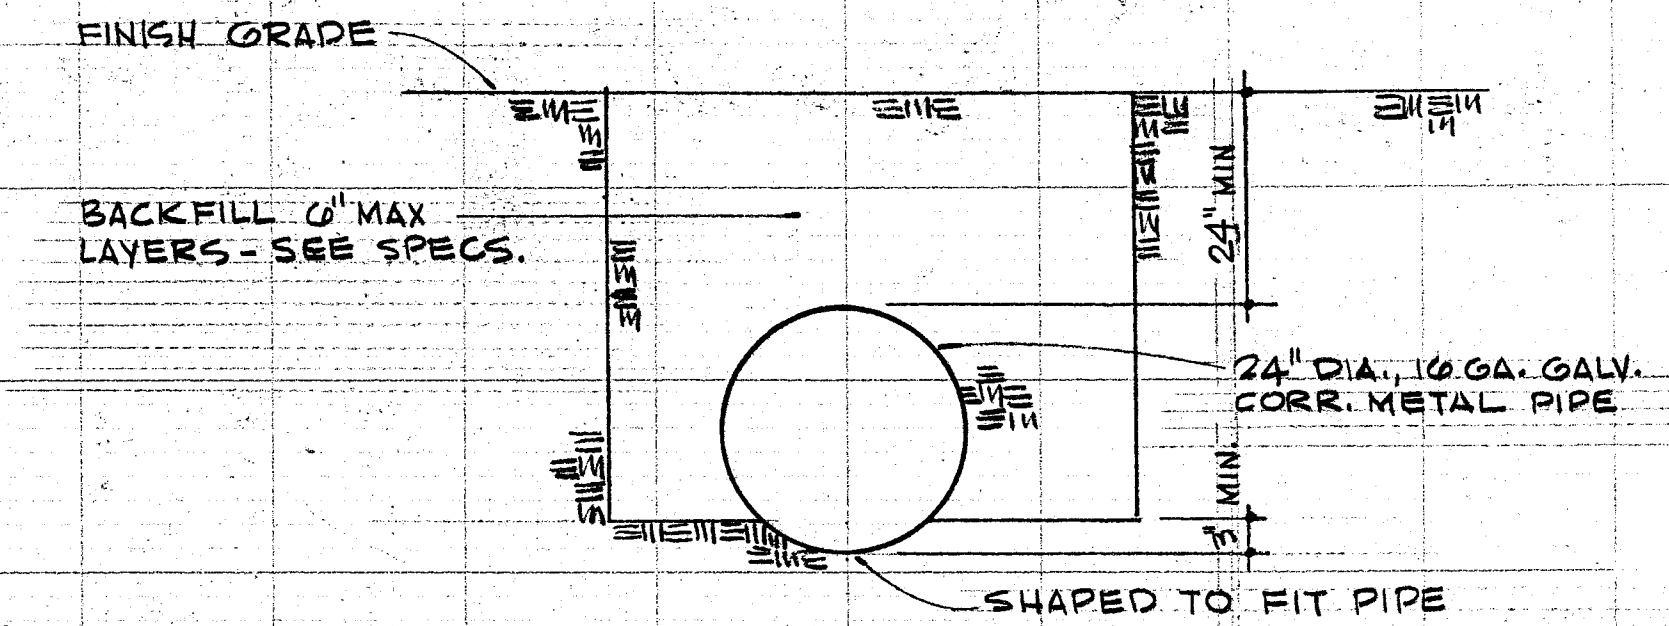

SECTION THRU DRAIN-TYP.
NO SCALE (SIMILAR FOR 18" DIA. PIPE)

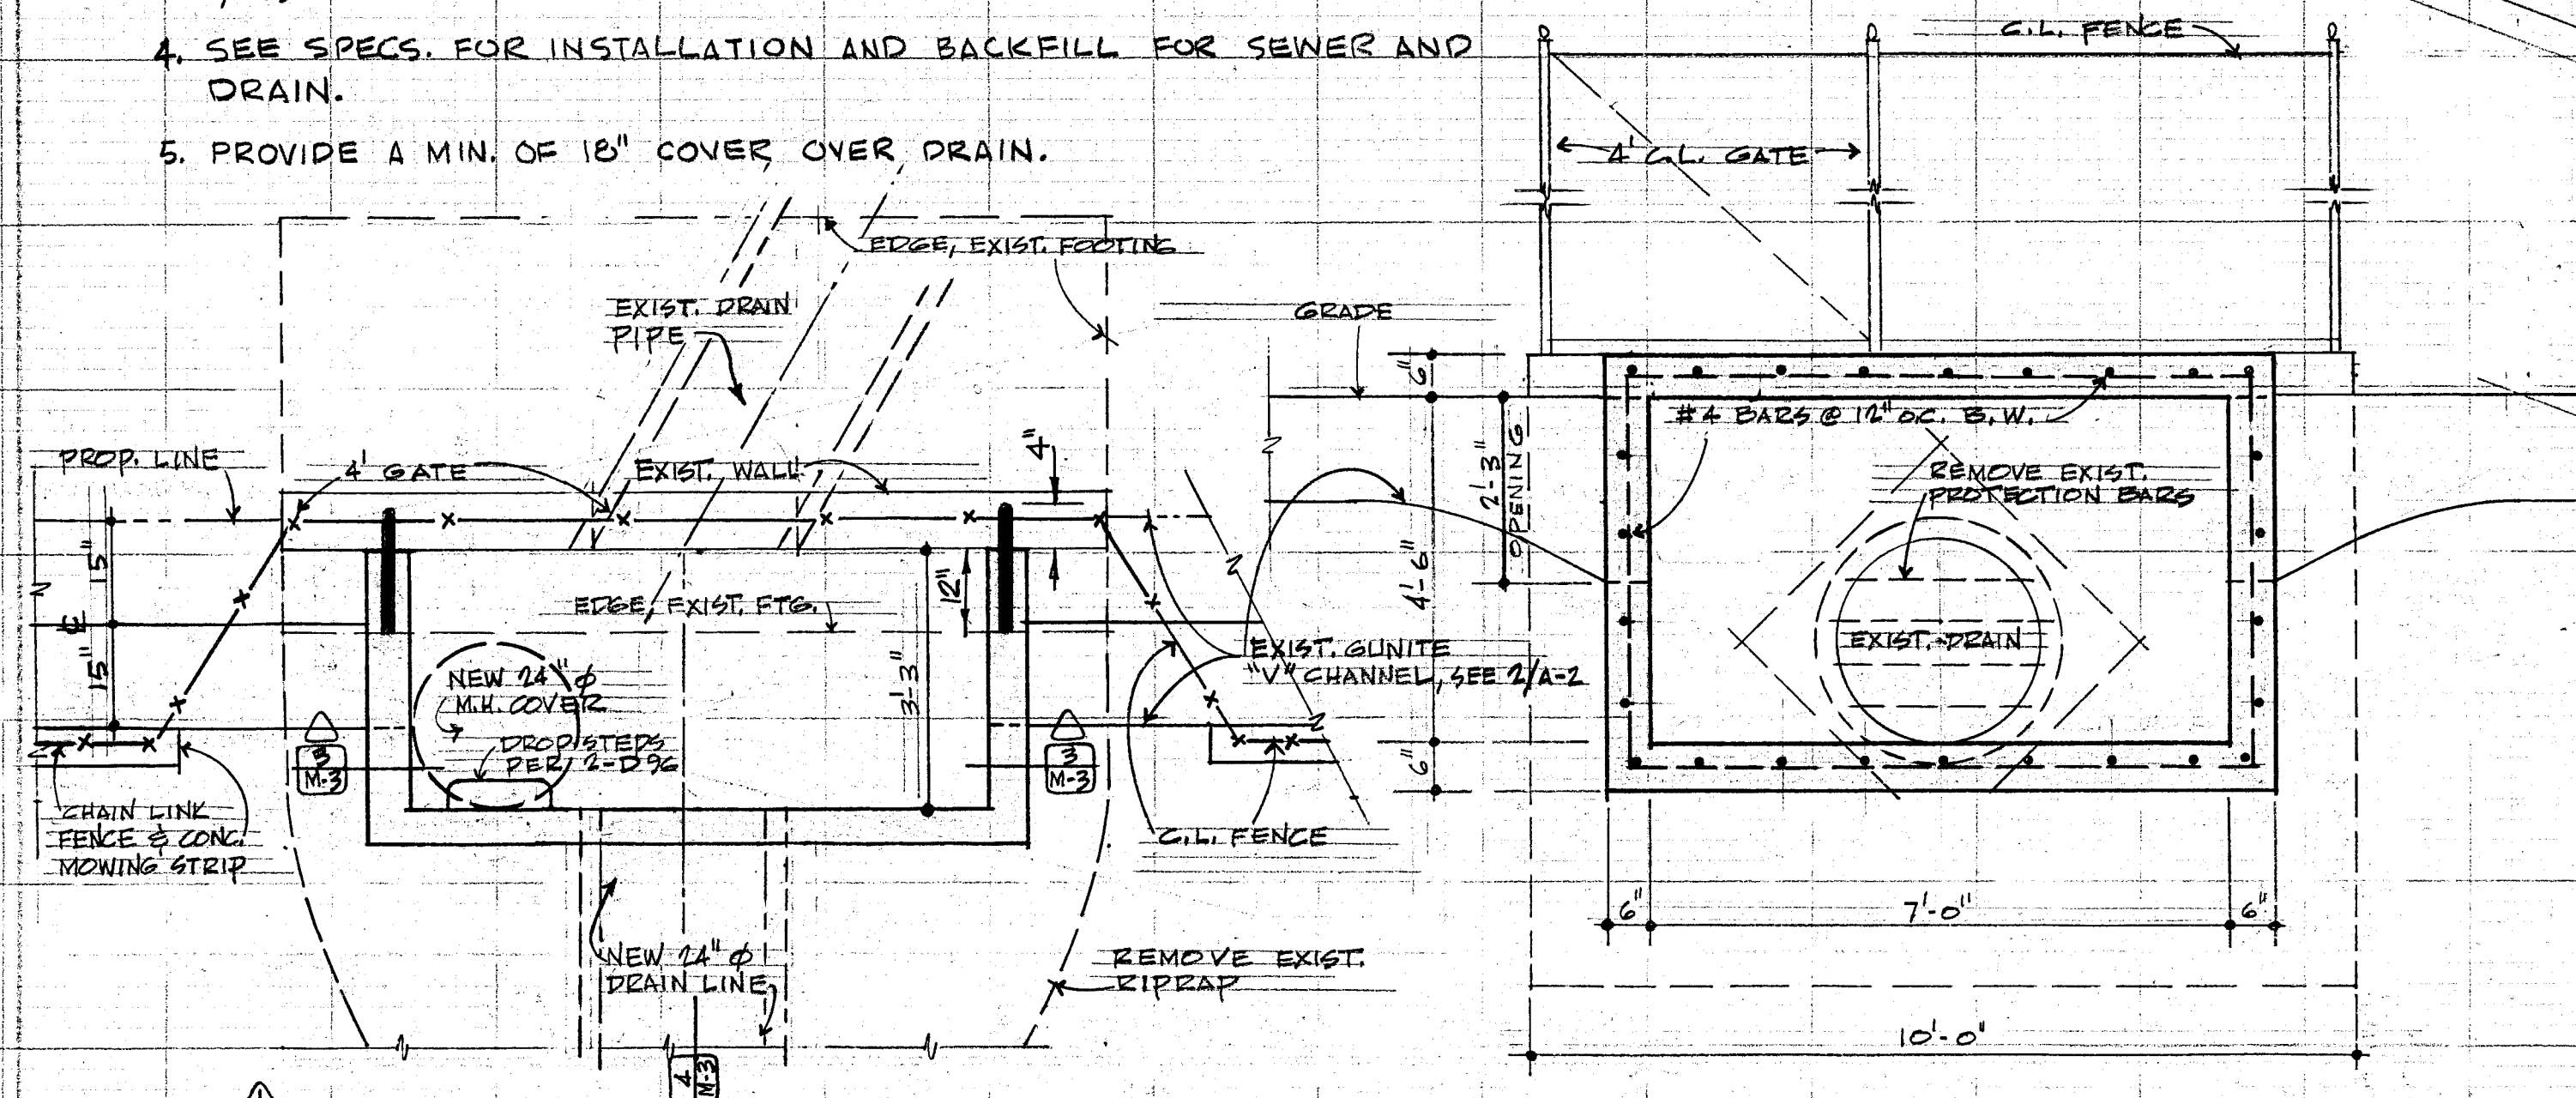

2 CATCH BASIN - PLAN 1/4" = 1'-0"

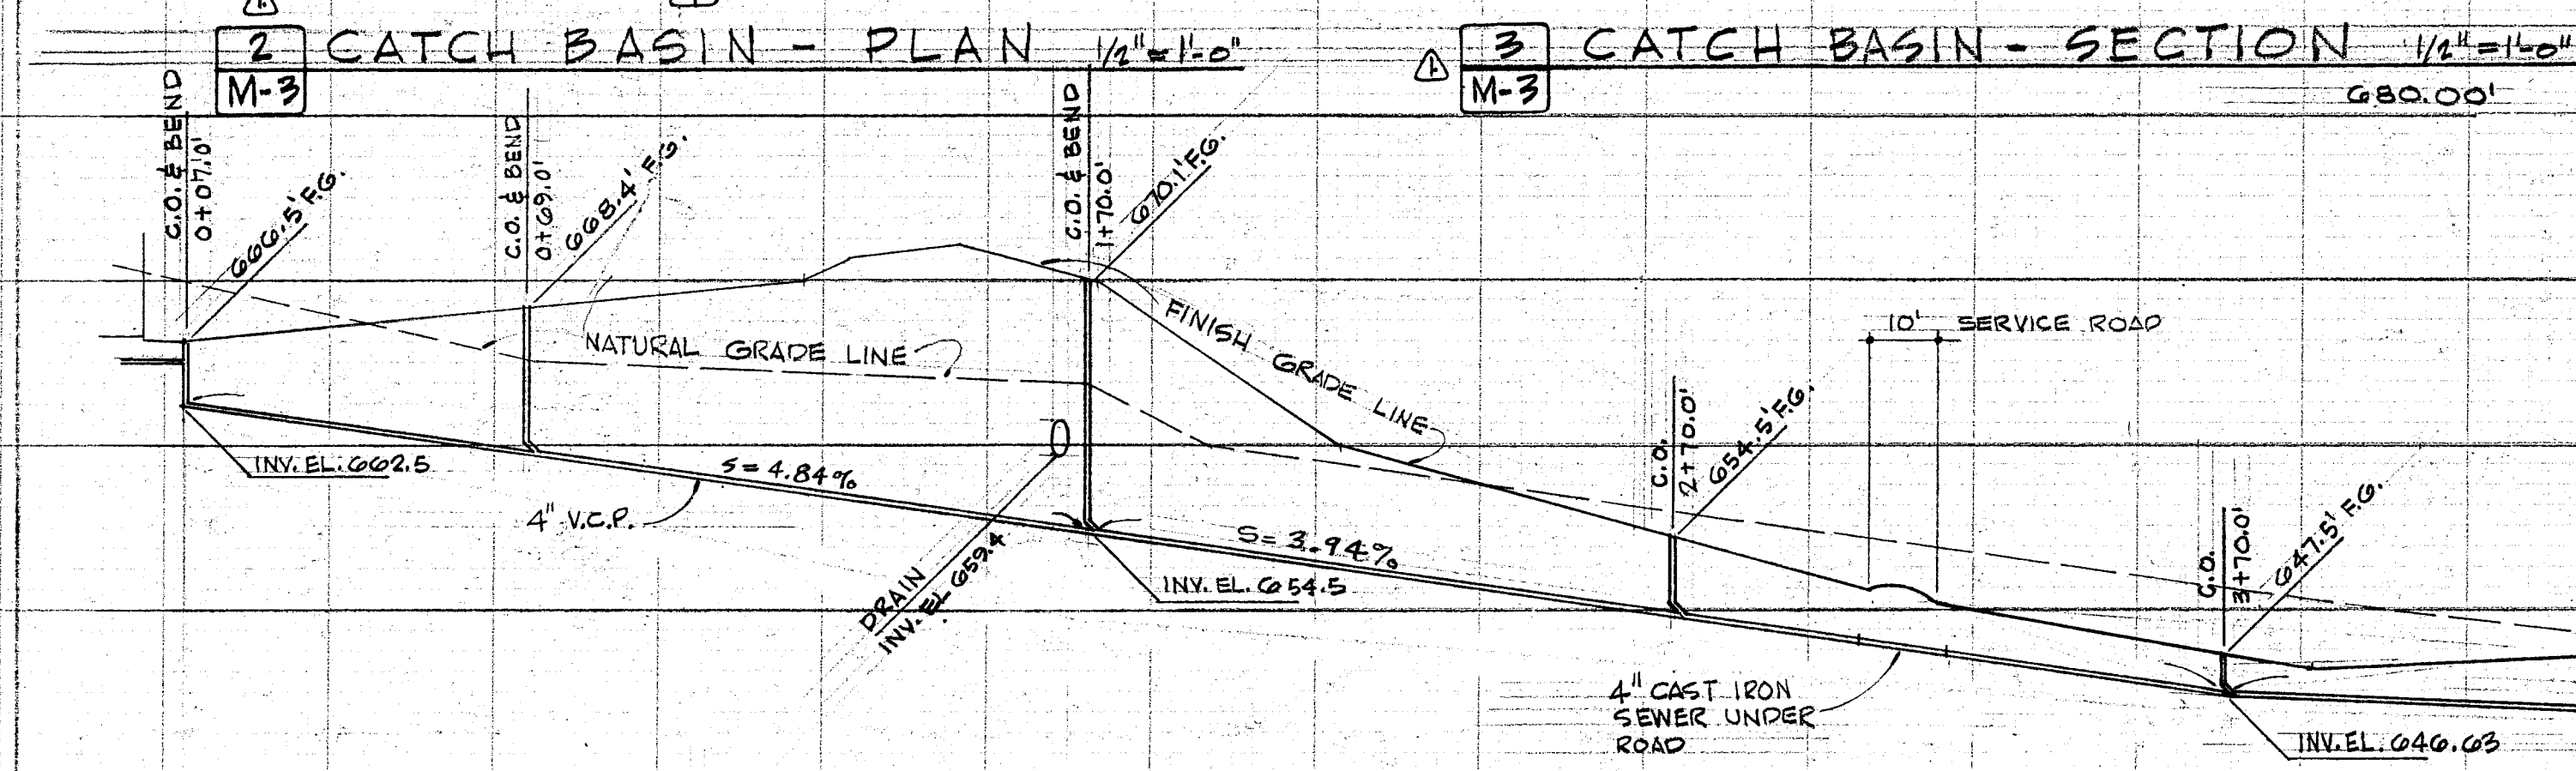


3 CATCH BASIN - SECTION 1/8" = 1'-0"

PROFILE OF SEWER FINISH


SCALE: HORIZ. 1"=30'; VERT. 1"=10'

NOTE: SEWER C.O. LOCATED 100'-0" O.C. MAX.

SEE DETAIL 1/M3

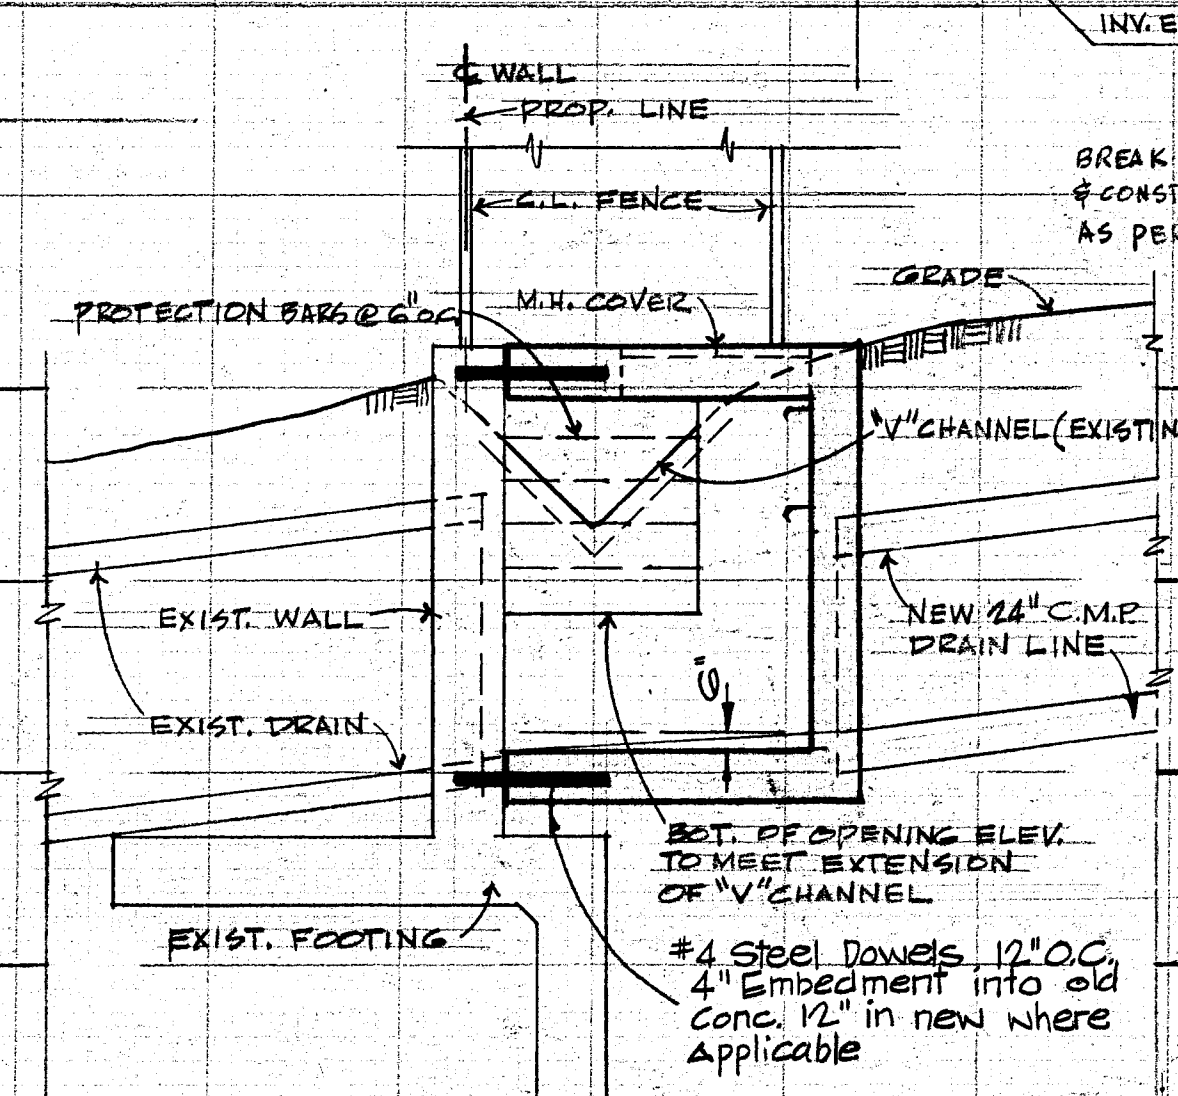

4 CATCH BASIN - SECTION 1/4" = 1'-0"

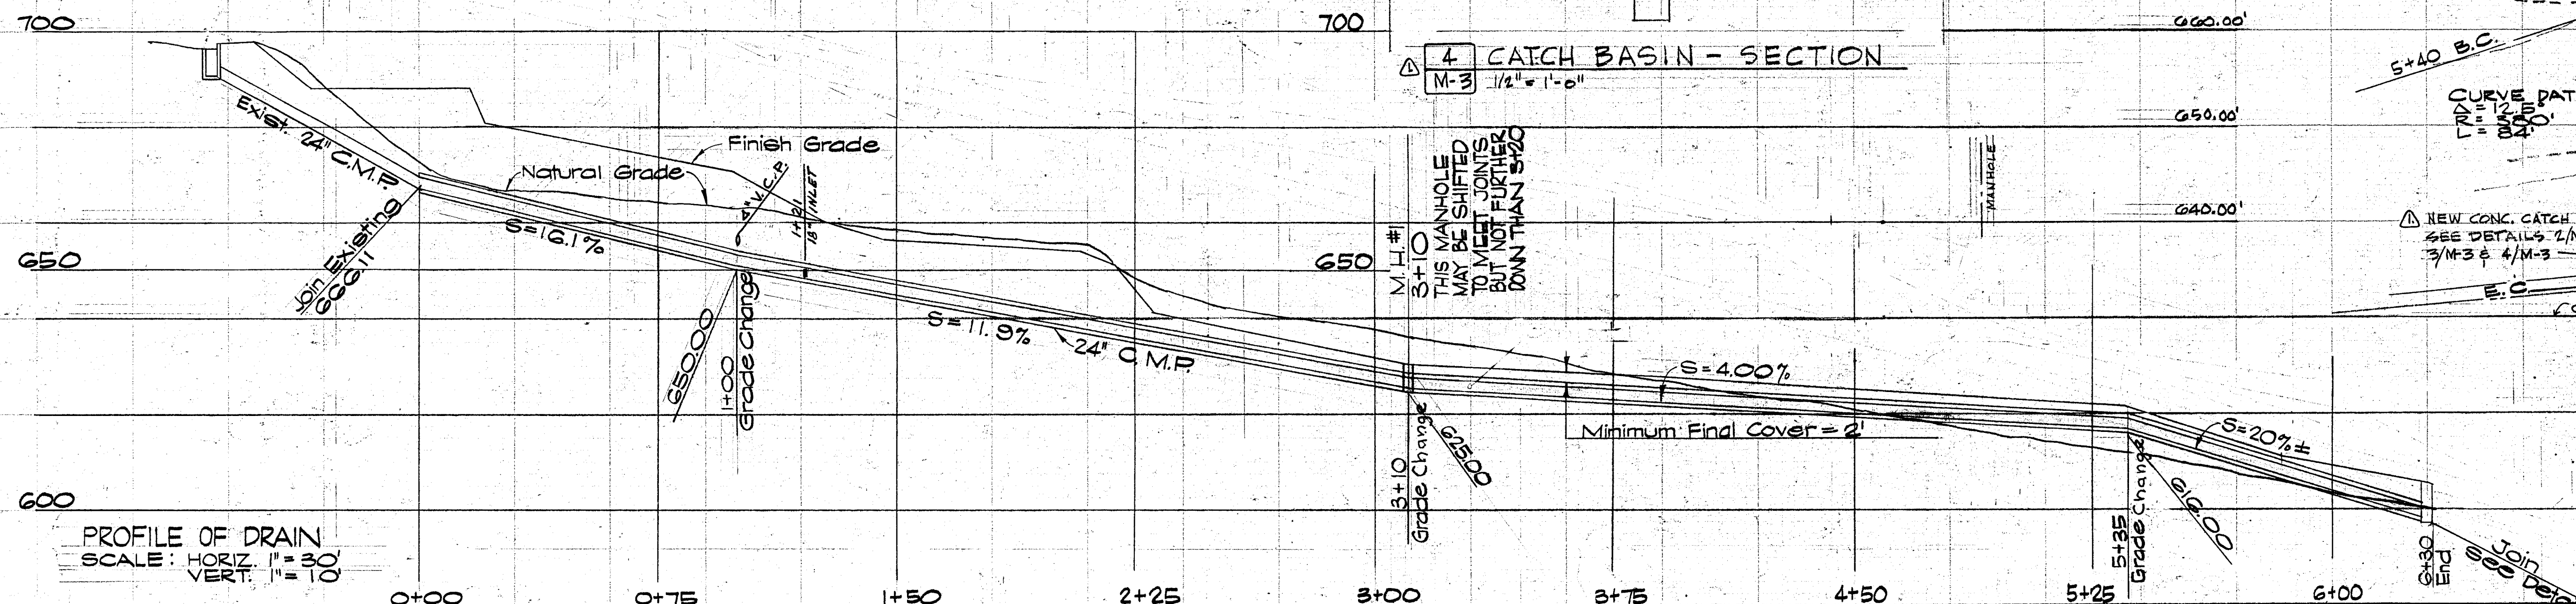

PROFILE OF DRAIN
SCALE: HORIZ. 1"=30'; VERT. 1"=10'

CHARLES B. READ JR.
STRUCTURAL ENGINEER
LONG BEACH, CALIF. CE 80976

EDWIN H. RIPPERDAN
ARCHITECT
3210 LONG BEACH BLVD. • LONG BEACH • CALIF. 90801

C-2337

REVISIONS	DATE	BY	APP. ENGINEER
1	1/27/70	CHB	CHB

ACTIVITY BUILDING & GENERAL DEVELOPMENT FOR THE COUNTY OF LOS ANGELES
PALOS VERDES COUNTY PARK
30359 S. HAWTHORNE BLVD.
PALOS VERDES, CALIF.

DRAIN & SEWER PLAN & PROFILE

AS BUILT
K-BUILT CORRECTIONS: SCALE: 1"=50'-0"
DRAWN BY: HCB
CHECKED BY: HCB
DATE: 1/27/70

CAP. PROJ. NO. 8809.02
SPEC. NO. 2379
ARCH. JOB NO. 025 OF 3