


EAST FILE CORP. IRVINE, CA
R.P.V. Park
Landscaping plan Sheet 118 of 2

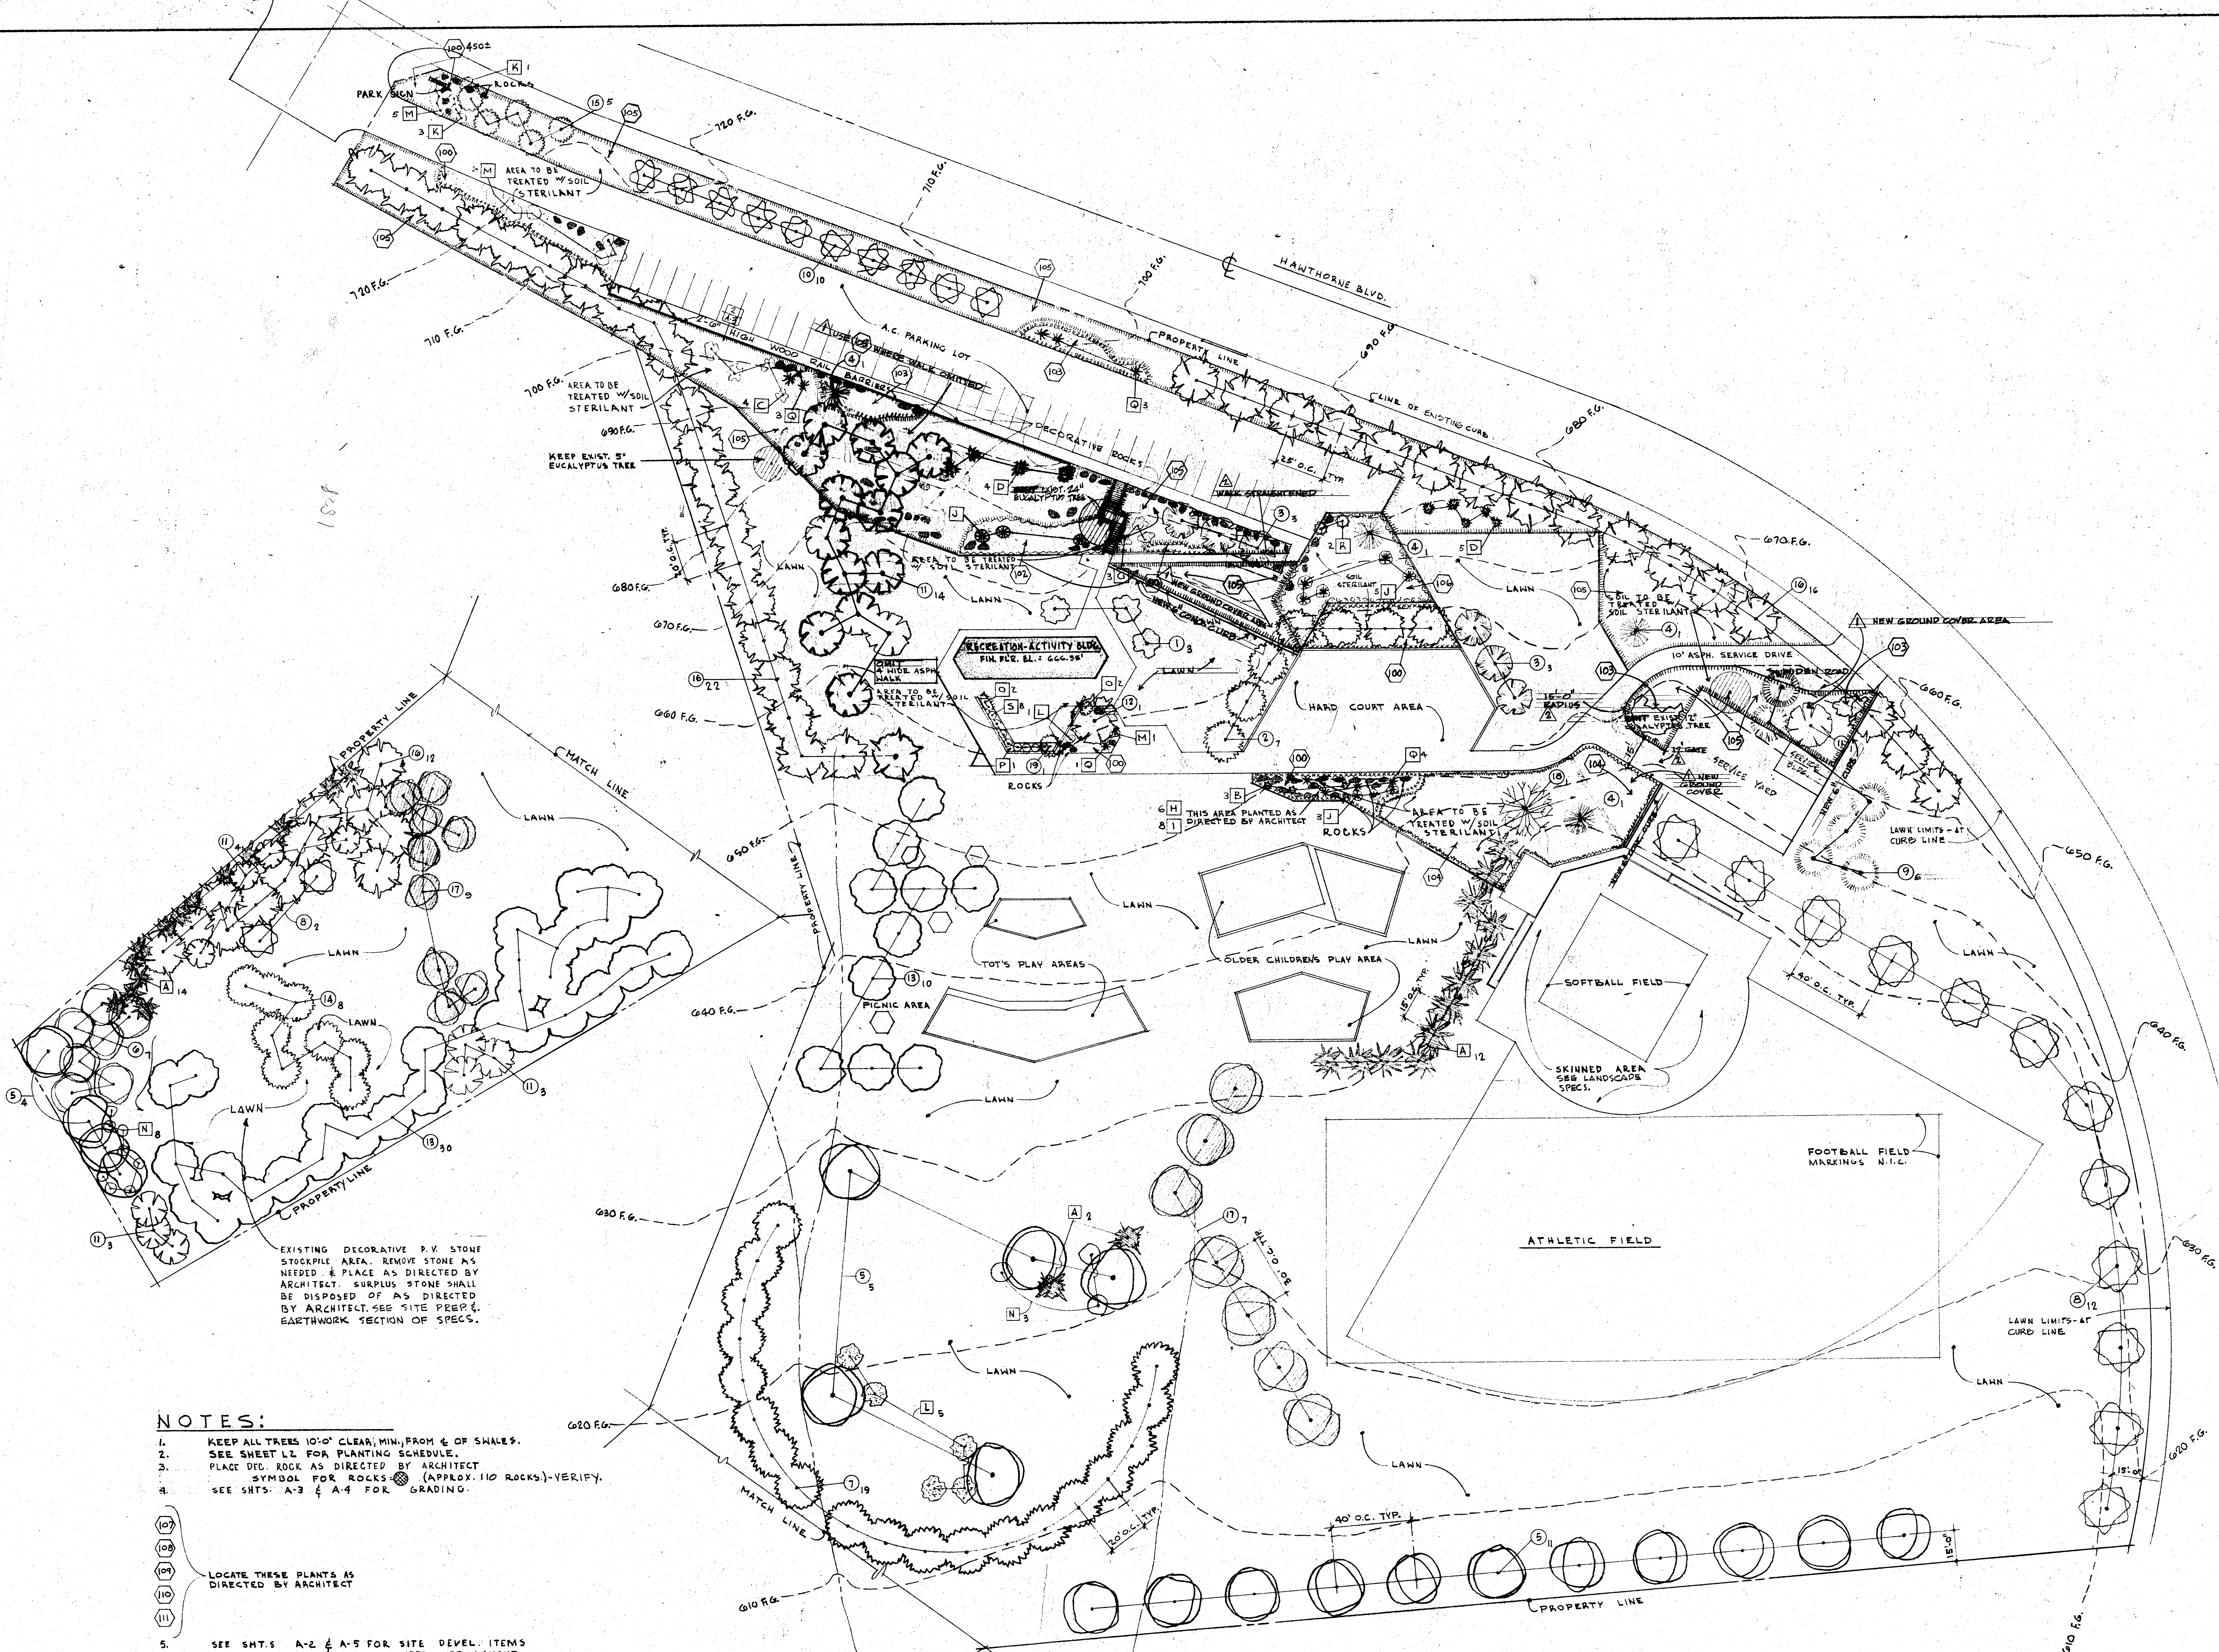

- NOTES:**
- KEEP ALL TREES 10'-0" CLEAR, MIN. FROM E. OF SHALES.
 - SEE SHEET L2 FOR PLANTING SCHEDULE.
 - PLACE DEC. ROCK AS DIRECTED BY ARCHITECT.
 - SYMBOL FOR ROCKS (APPROX. 110 ROCKS)-VERIFY.
 - SEE SHTS. A-3 & A-4 FOR GRADING.
- LOCATE THESE PLANTS AS DIRECTED BY ARCHITECT
- SEE SHTS. A-2 & A-5 FOR SITE DEVEL. ITEMS
- THE SOIL SHALL BE STERILIZED IN ALL SHRUB PLANTING & GRASS COVER AREAS - NOT IN LAWN AREAS.
- CONCRETE BORDERS TO BE INSTALLED BY THIS CONTR. EXCEPT AT EDGES OF ALL PARKING WHERE SHOWN

EDWARD R. LOVELL • A.S.L.A.
LANDSCAPE ARCHITECT
3916 PINE AVE • LONG BEACH • CALIF.

EDWIN H. RIPPERDAN
ARCHITECT
3610 LONG BEACH BLVD • LONG BEACH • CALIF. 424-6701

REVISIONS
1. AS-BUILT CORRECTIONS
2. 2/27/70

ACTIVITY BUILDING & GENERAL DEVELOPMENT FOR THE COUNTY OF LOS ANGELES
PALOS VERDES COUNTY PARK
30359 S. HAWTHORNE BLVD. PALOS VERDES • CALIFORNIA

LANDSCAPING PLAN		CAP. PROJ. NO. 6859.01		SHEET	
AS-BUILT CORRECTIONS	SCALE	DRAWN BY:	CHECKED BY:	DATE: 6-8-64	SPEC. NO. 2379
2/27/70	1"=30'-0"	46, LK	EL, E.H.R.	REVISED: 9-21-68	ARCH. JOB NO. 628
107-114 SUPP. SPEC. 2379				OF 2	