CORPS OF ENGINEERS

U.S. ARMY

CH (Barracks) Site Utilitie 1963

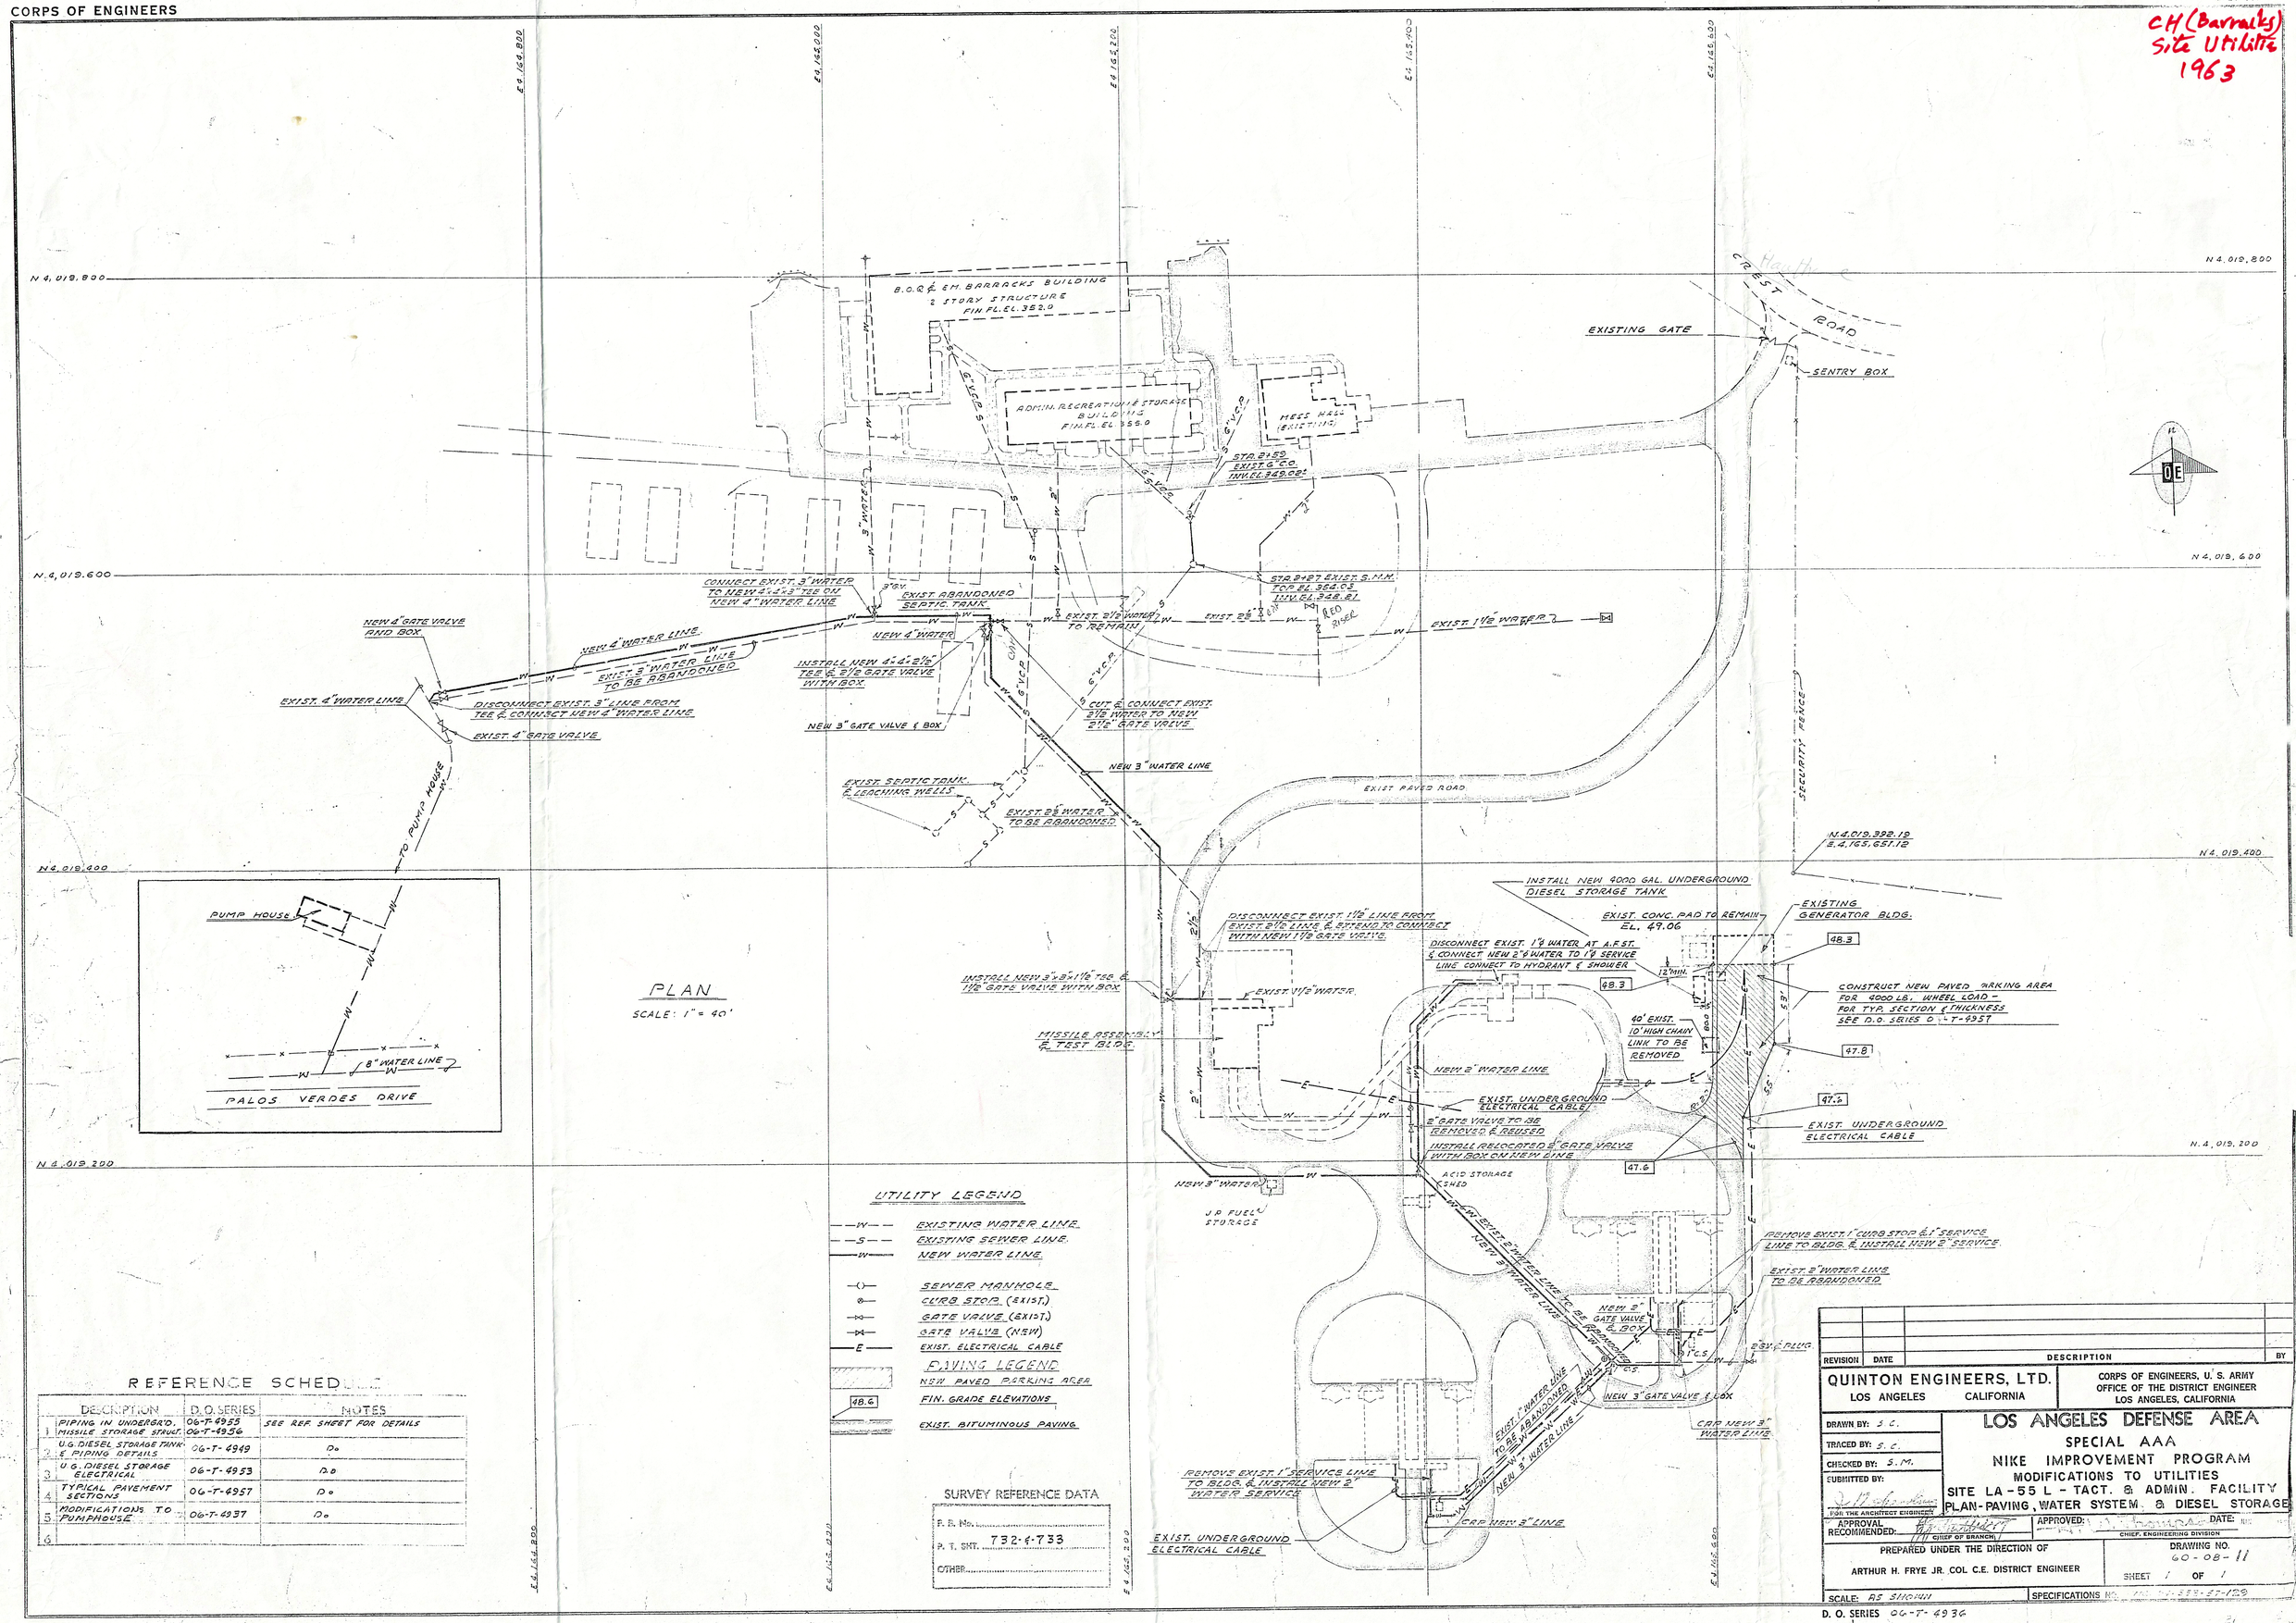

PLAN

SCALE: 1" = 40'

UTILITY LEGEND

- EXISTING WATER LINE
- EXISTING SEWER LINE
- NEW WATER LINE
- SEWER MANHOLE
- CURB STOP (EXIST.)
- GATE VALVE (EXIST.)
- GATE VALVE (NEW)
- EXIST. ELECTRICAL CABLE

PAVING LEGEND

- NEW PAVED PARKING AREA
- 48.6 FIN. GRADE ELEVATIONS
- EXIST. BITUMINOUS PAVING.

REFERENCE SCHEDULE

	DESCRIPTION	D.O. SERIES	NOTES
1	PIPING IN UNDERGR'D. MISSILE STORAGE STRUCT.	06-T-4955 06-T-4956	SEE REF. SHEET FOR DETAILS
2	U.G. DIESEL STORAGE TANK & PIPING DETAILS	06-T-4949	Do
3	U.G. DIESEL STORAGE ELECTRICAL	06-T-4953	Do
4	TYPICAL PAVEMENT SECTIONS	06-T-4957	Do
5	MODIFICATIONS TO PUMPHOUSE	06-T-4937	Do
6			

SURVEY REFERENCE DATA

F. B. No.
P. T. SHT. 732-4-733
OTHER

REVISION	DATE	DESCRIPTION	BY

QUINTON ENGINEERS, LTD.
LOS ANGELES CALIFORNIA

CORPS OF ENGINEERS, U. S. ARMY
OFFICE OF THE DISTRICT ENGINEER
LOS ANGELES, CALIFORNIA

DRAWN BY: S. C.
TRACED BY: S. C.
CHECKED BY: S. M.
SUBMITTED BY:
FOR THE ARCHITECT ENGINEER
APPROVAL RECOMMENDED: CHIEF OF BRANCH
APPROVED: CHIEF, ENGINEERING DIVISION
DATE:

LOS ANGELES DEFENSE AREA

SPECIAL AAA
NIKE IMPROVEMENT PROGRAM
MODIFICATIONS TO UTILITIES
SITE LA-55 L - TACT. & ADMIN. FACILITY
PLAN-PAVING, WATER SYSTEM & DIESEL STORAGE

PREPARED UNDER THE DIRECTION OF
ARTHUR H. FRYE JR. COL. C.E. DISTRICT ENGINEER

DRAWING NO. 60-08-11
SHEET 1 OF 1

SCALE: AS SHOWN
SPECIFICATIONS NO.

D. O. SERIES 06-T-4936

FILE NO. 500K