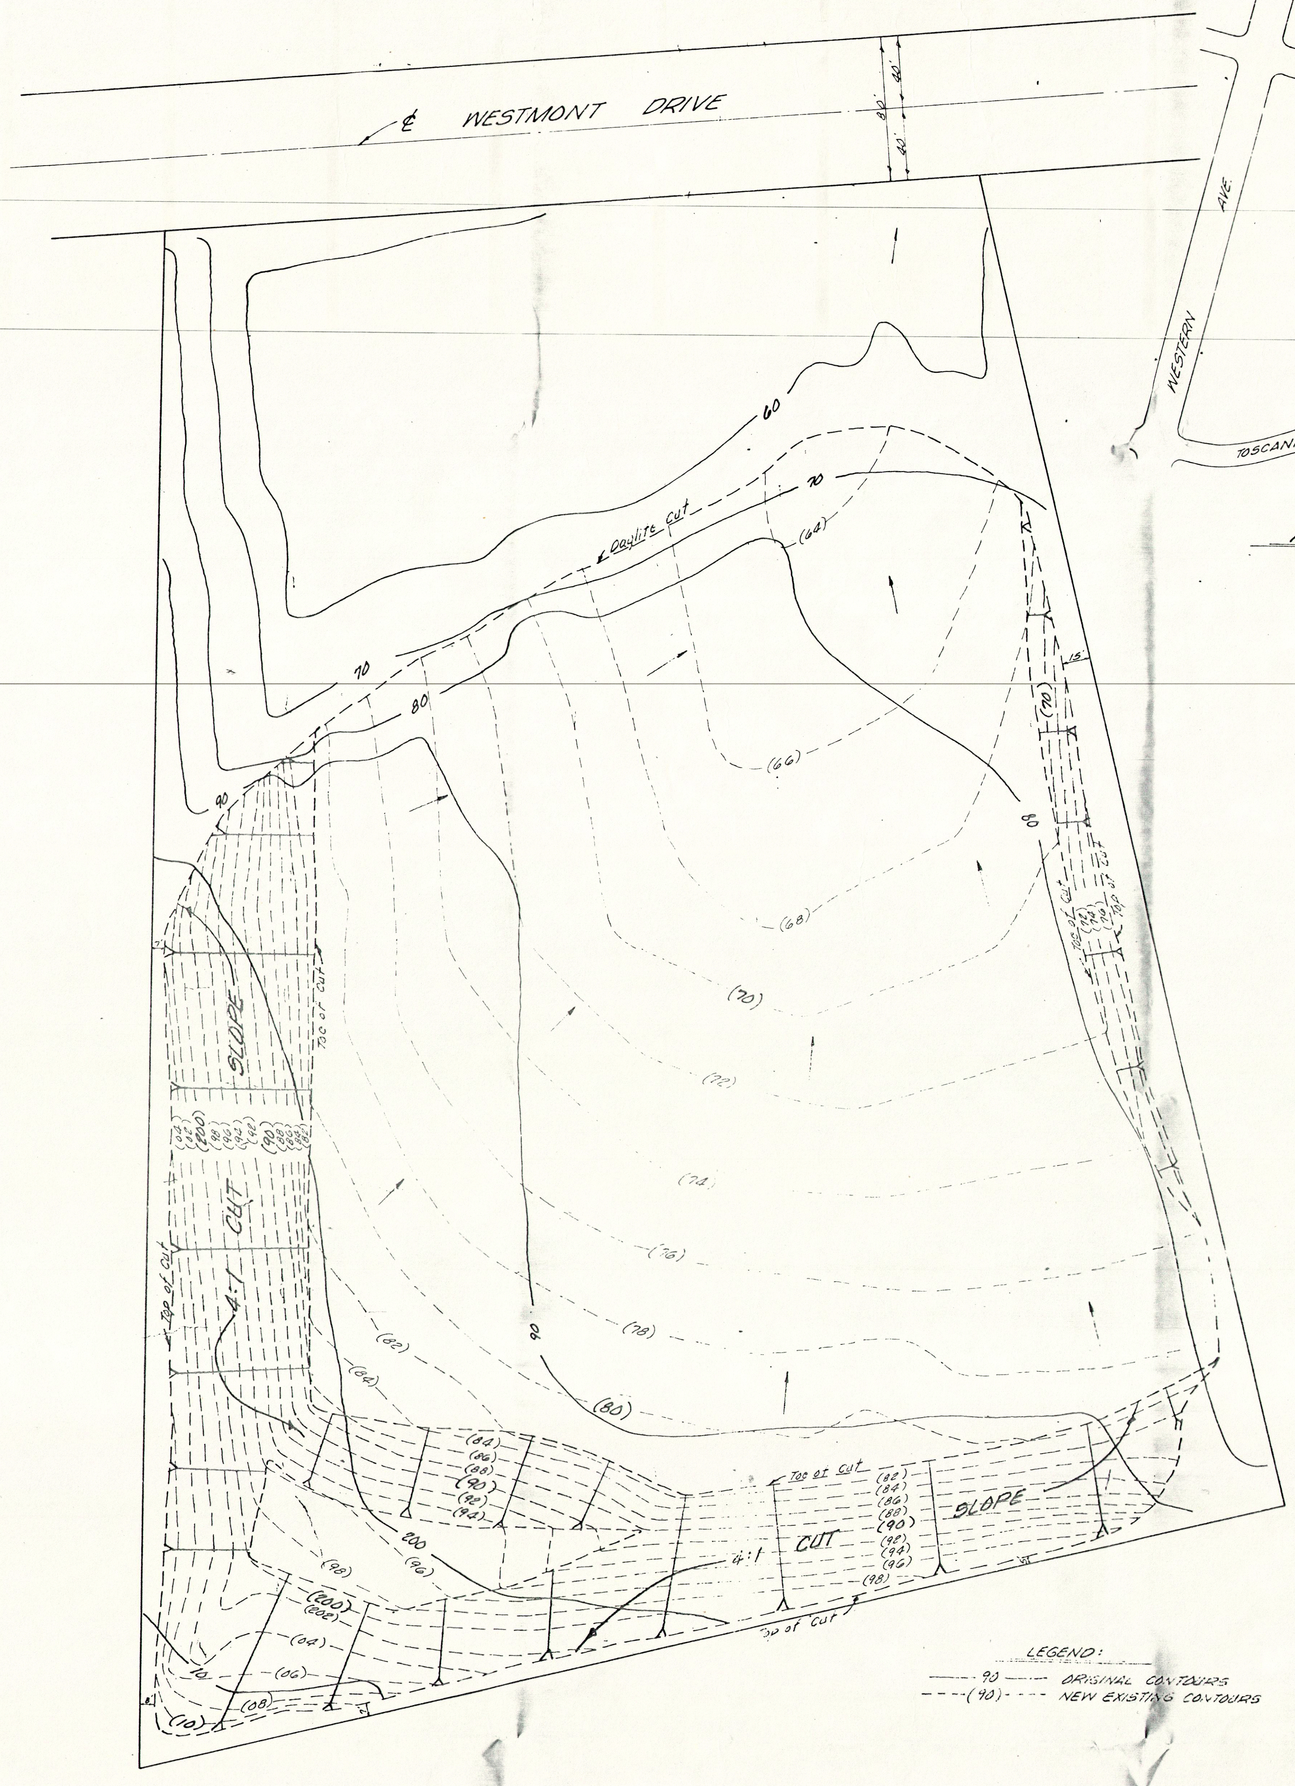

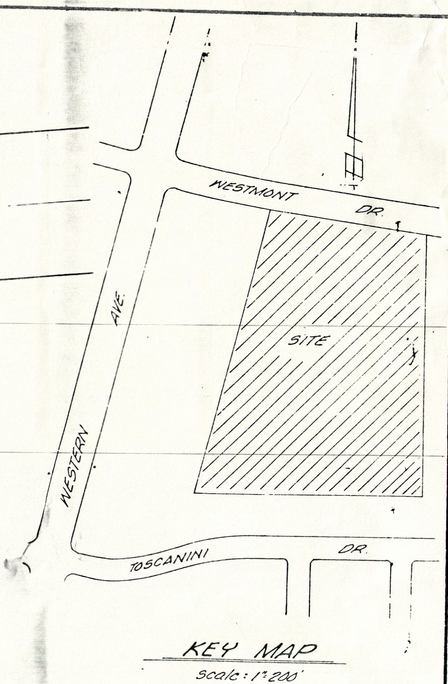

KEY MAP
scale: 1" = 200'

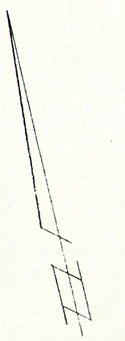

scale: 1" = 40'

"AS-BUILT GRADING PLAN"

PORTION OF LOT 1, TR. NO. 3192, PER M.B. 42-91/92, COUNTY OF LOS ANGELES STATE OF CALIFORNIA

SOILS ENGINEER & GEOLOGIST
S.E. MEDALL & ASSOC. INC.
3093 S. BUNDY DRIVE
LOS ANGELES, CALIF. 90066
390-4079

PERMITTEE:
BUENA BUILDING CO.
9030 BUNDY DR.
LOS ANGELES, CALIF. 90066
390-8080

REVISION	By	date

JENNINGS ENGINEERING CO.
CIVIL ENGINEERS
4419 VAN NUYS BLVD.
SHERMAN OAKS
CALIFORNIA 91403
783-1748
872-3915

WESTERN AVE SHAFT SITE
GRADING PLAN
OWNER: COUNTY SANITATION DIST.
3020 BEVERLY BLVD.
LOS ANGELES, CALIF.
484-1870

date 4-23-78
drawn J.B.
designed
checked M.L.
sheet no. 1
of sheets