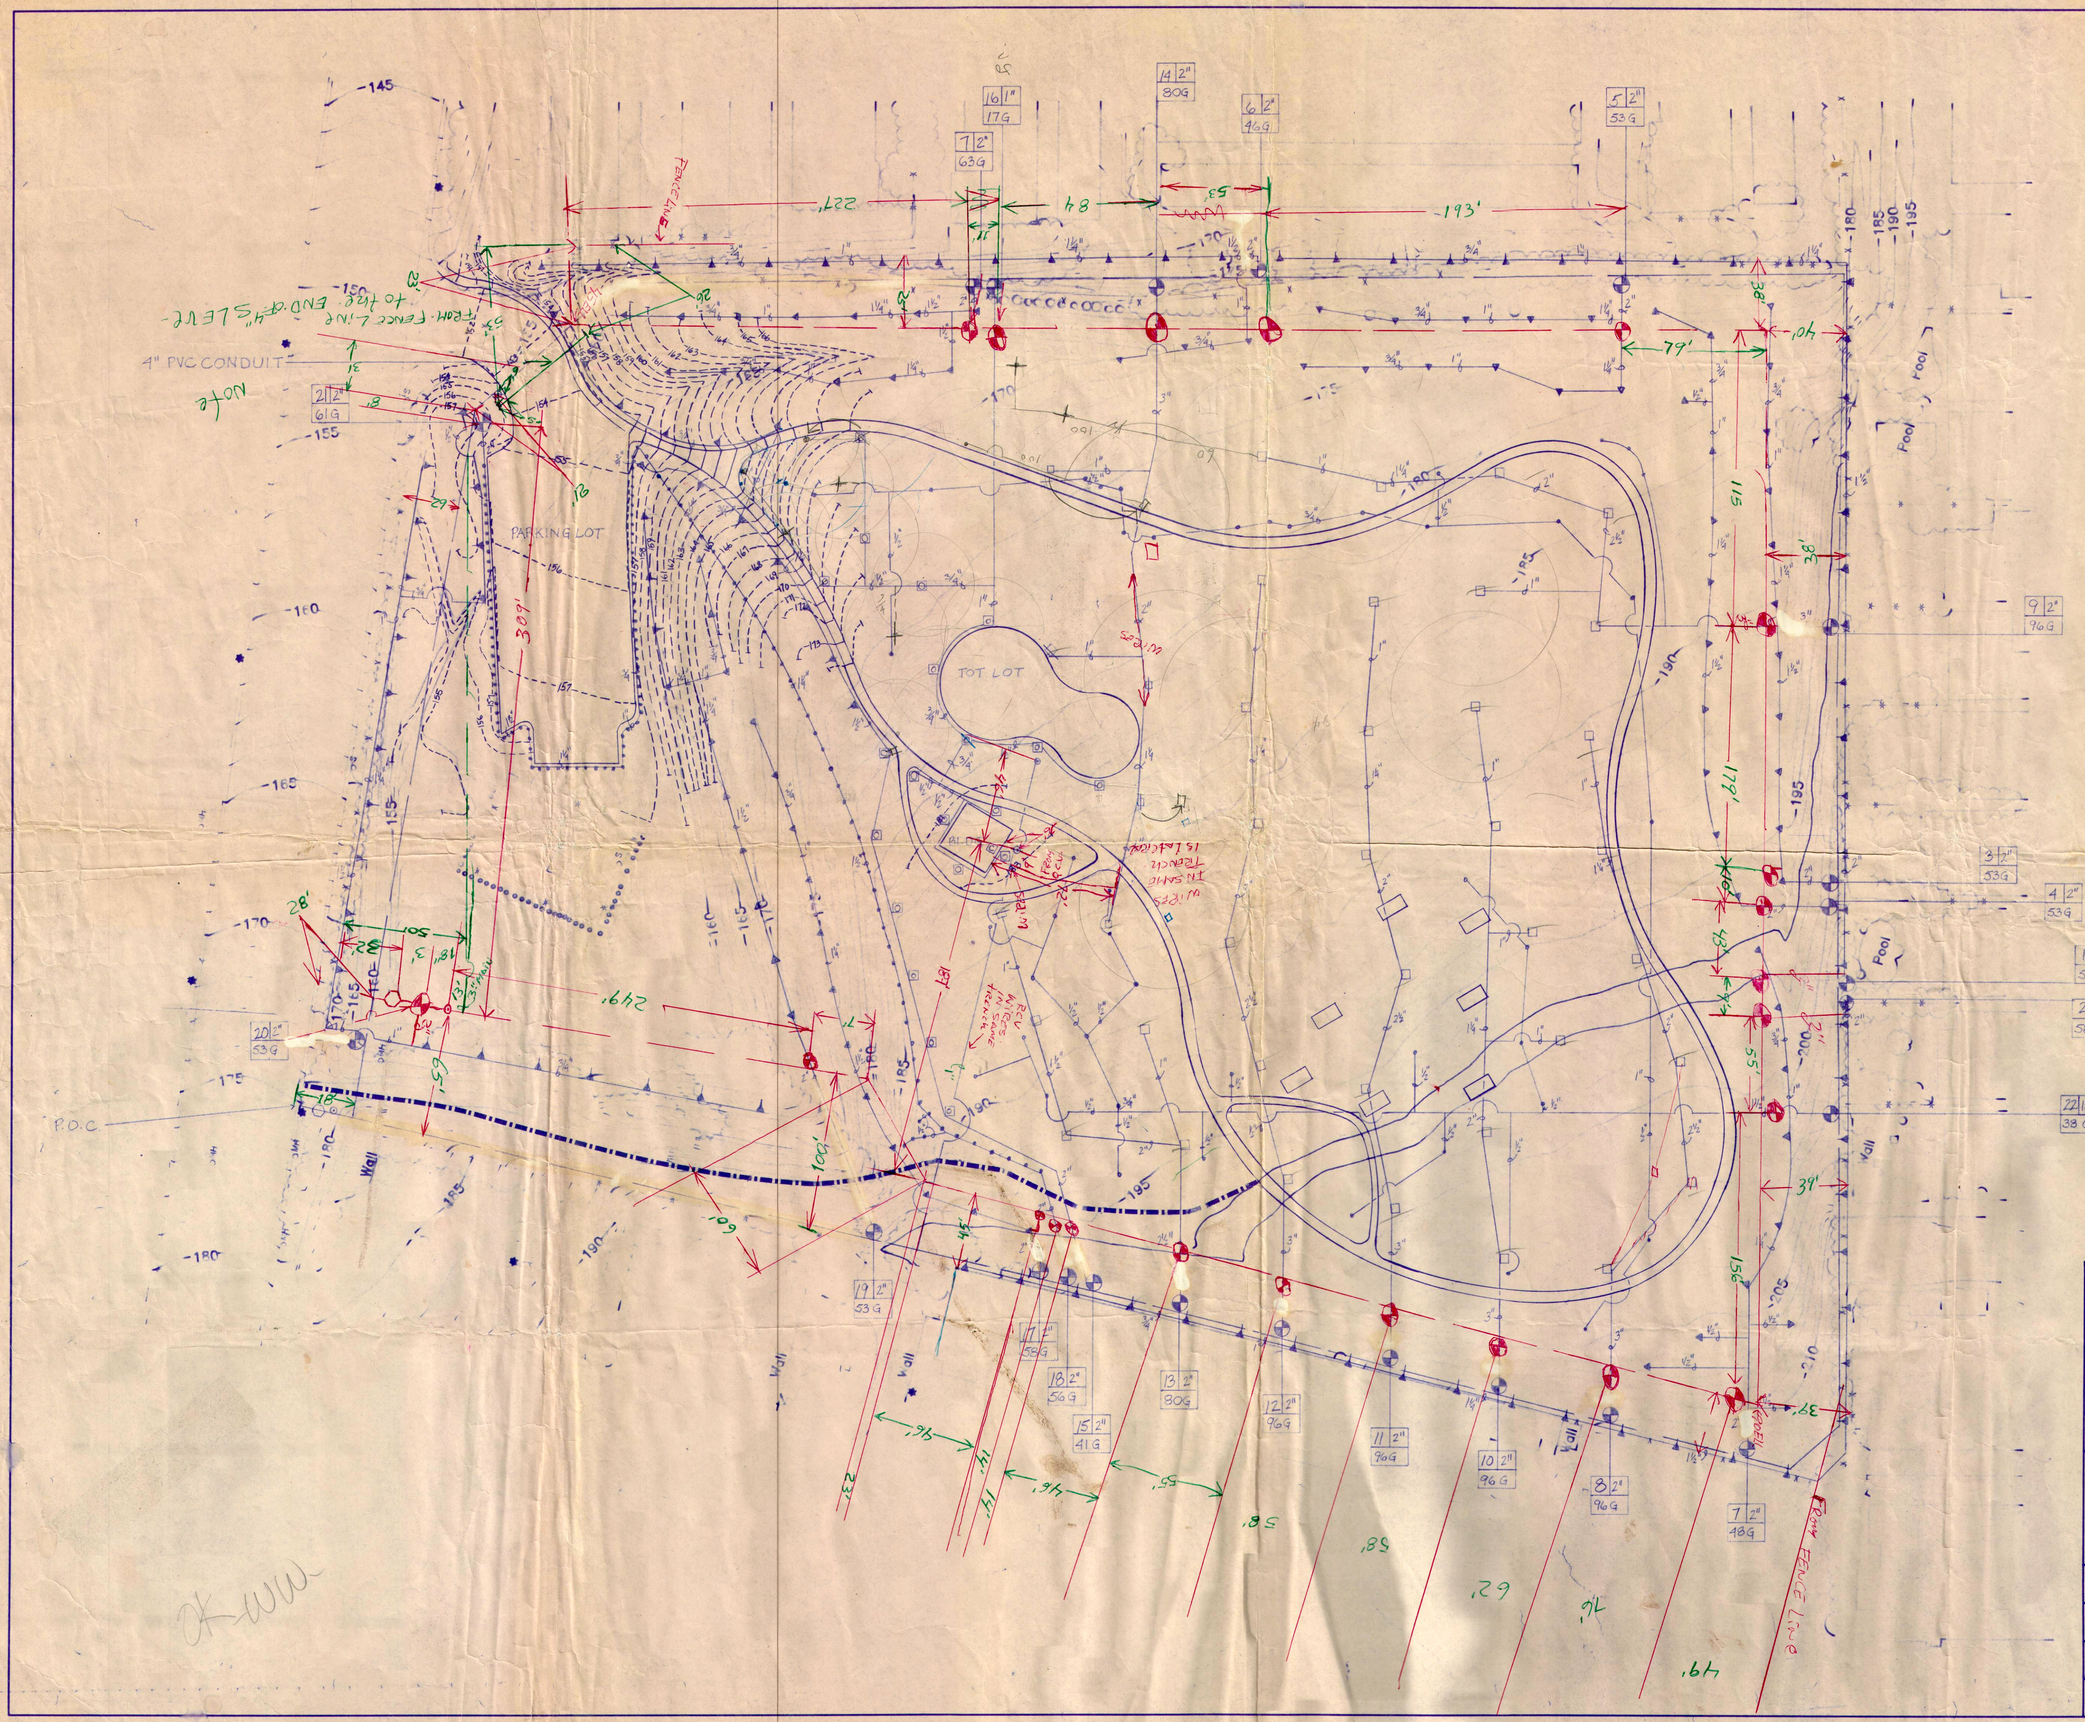


| NO. | DESCRIPTION | DAT |
|---|---|---|
| △ | IRRIGATION PLAN 1"=40' | 12-8 |
| △ | | |
| △ | | |
| △ | | |
| △ | | |

REVISIONS

**RANCHO PALOS VERDE**

# EASTVIEW PARK

1700 WESTMONT AVE.

APPROVED BY
CITY ENGINEER _____ DATE _____
R.C.E. N

DESIGNED: W. WARRINER
DRAWN: W.W.
CHECKED:

DATE _____ R.C.E. NO. _____ FILE NO. _____

JO

FIL