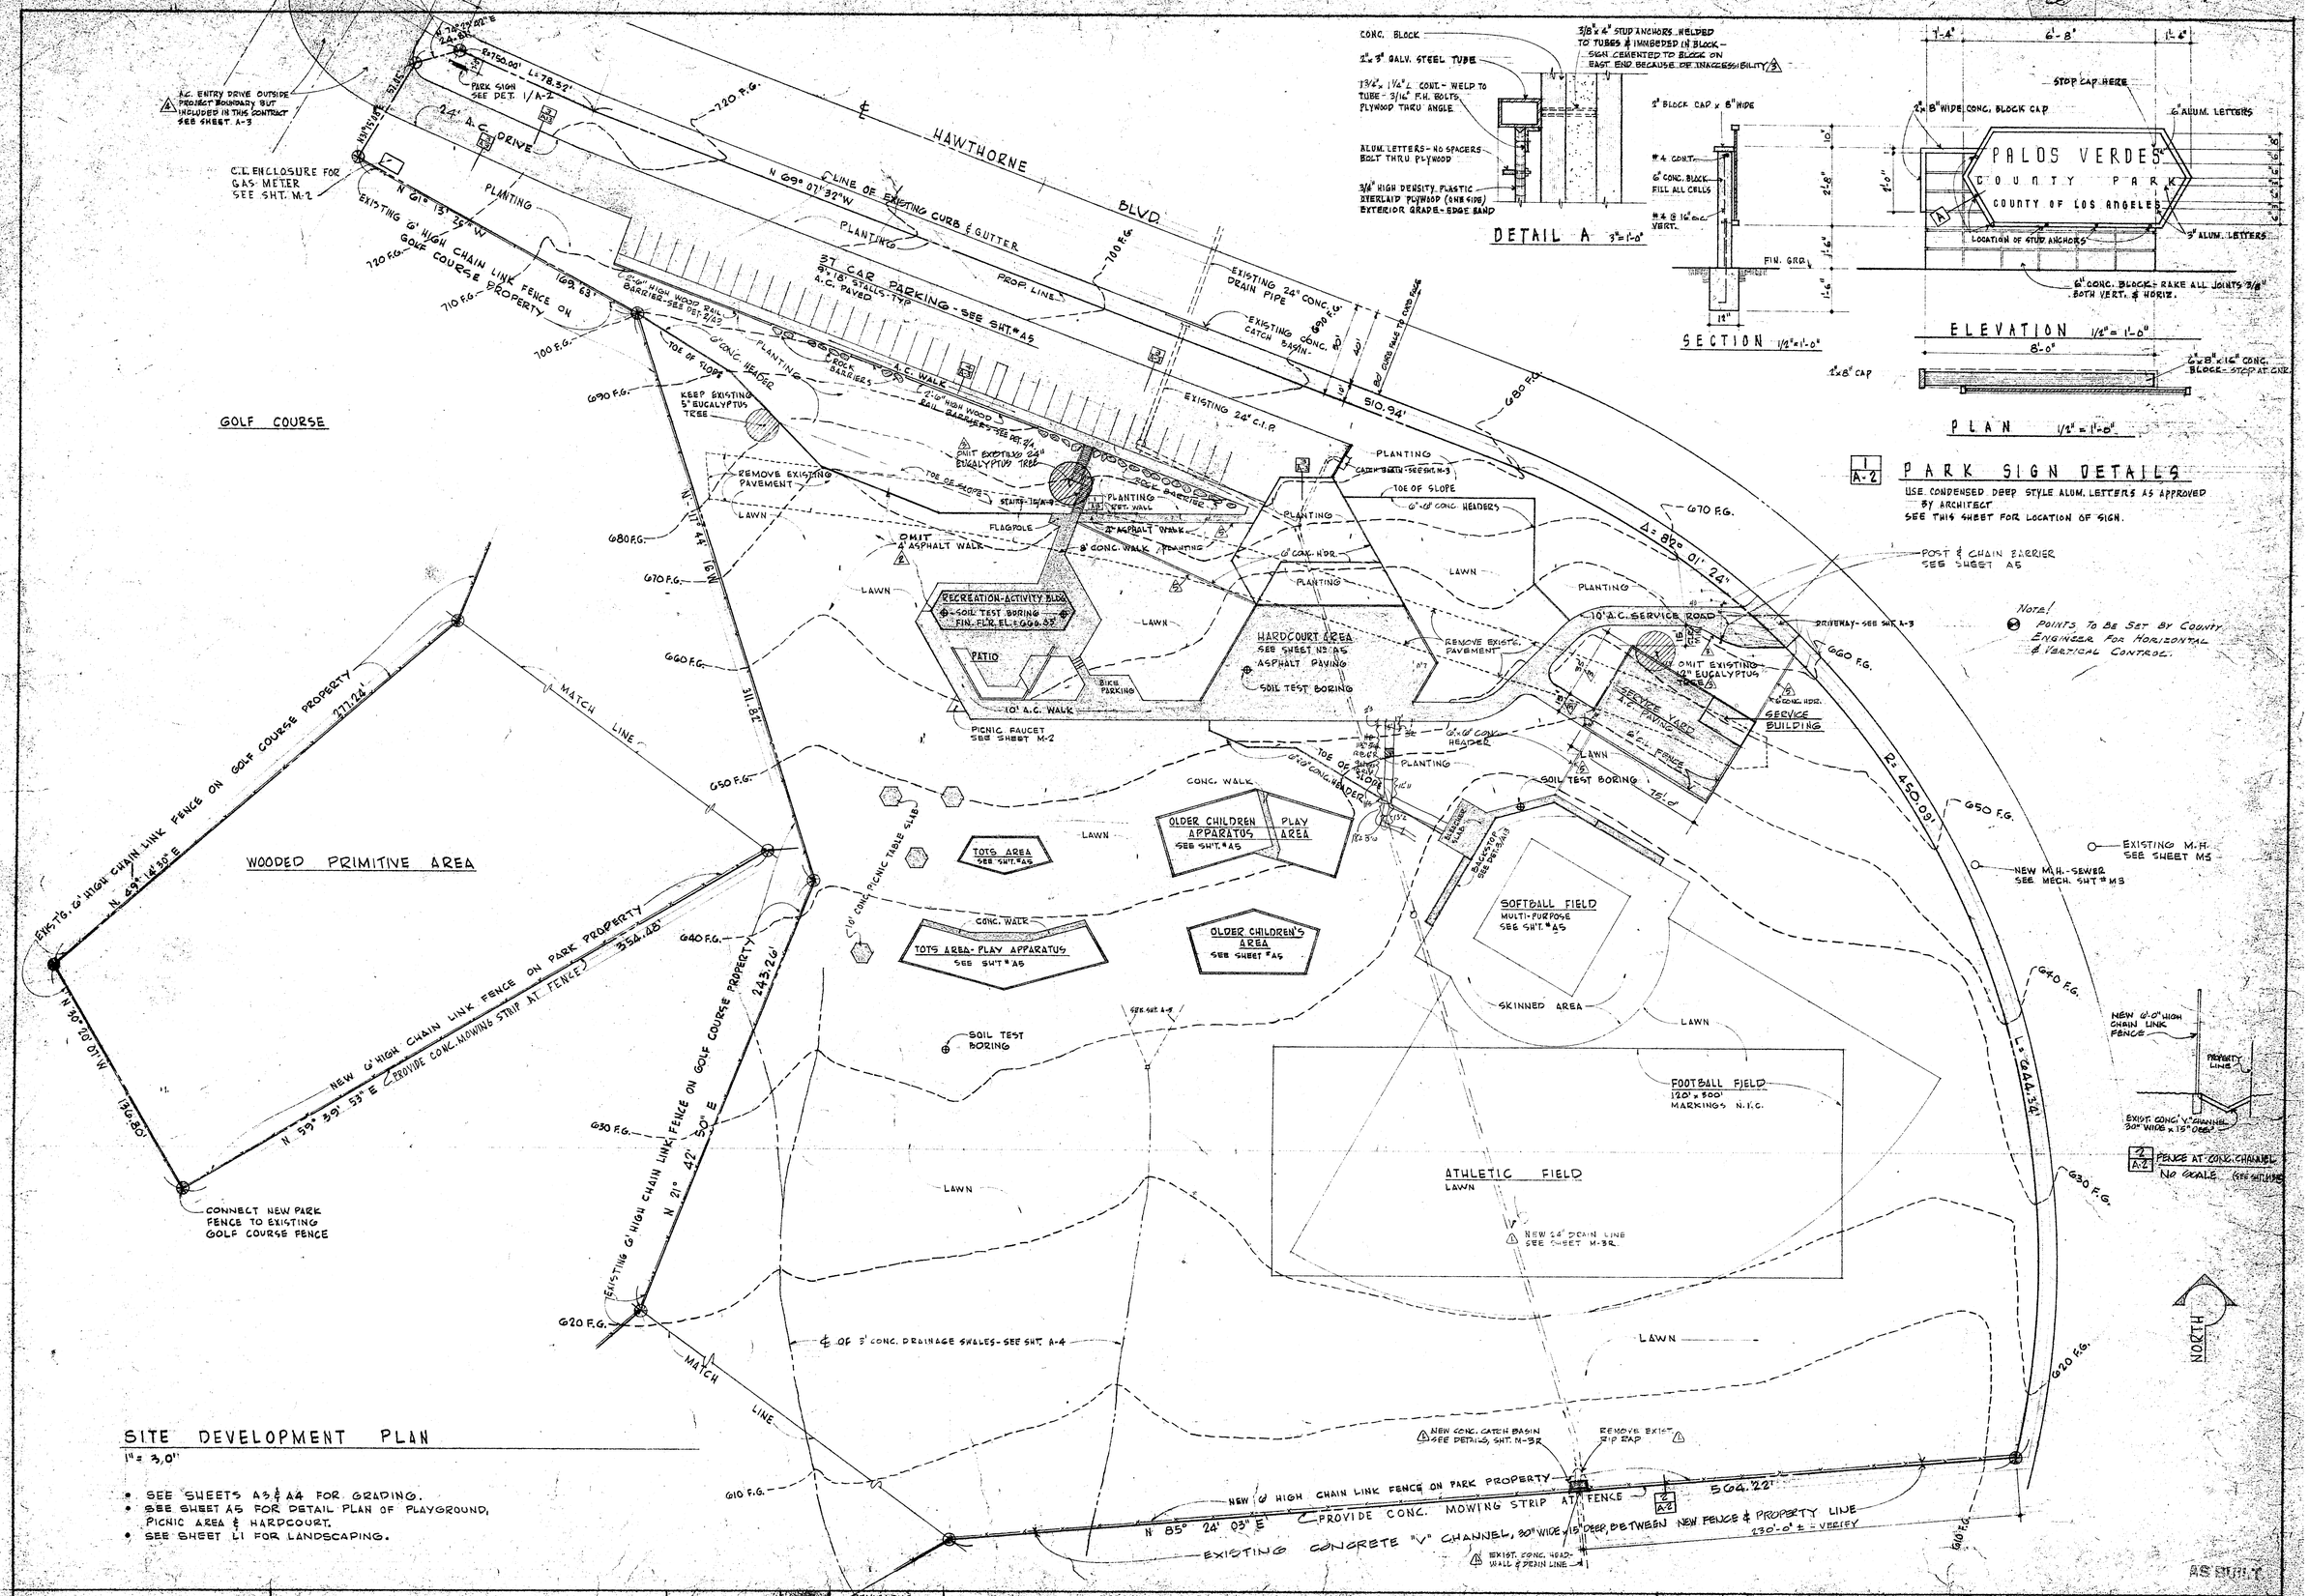

EDWIN H. RIPPERDAN
ARCHITECT
8610 LONG BEACH BLVD. · LONG BEACH · CALIF. 424-6701

C-2307

REVISIONS

ACTIVITY BUILDING & GENERAL DEVELOPMENT FOR THE COUNTY OF LOS ANGELES
PALOS VERDES COUNTY PARK
30250 S. HAWTHORNE BLVD. PALOS VERDES · CALIFORNIA

SITE DEVELOPMENT PLAN

ACTIVITY CORRECTIONS	SCALE	DRAWN BY:	CHECKED BY:	DATE / REVISIONS
2/27/70	1" = 30'-0"			6-5-69 / 8-26-69 / 9-27-69 / 11-12-69

CAP. PROJ. No. 63-204 · SPEC. No. 2379 · SHEET A2B · JOB No. 628

AS BUILT