FINISH SCHEDULE - SEE INTERIOR PAINT KEY AND SPECS.

ROOM NUMBER	ROOM NAME	FLOOR: CONCRETE	FLOOR: CERAMIC TILE	BASE: 4" CEMENT - DETAIL 1/A8	BASE: 4" CERAMIC TILE - DETAIL 2/A8	BASE: NONE	NORTH WALL	EAST WALL	SOUTH WALL	WEST WALL	WAINSCOT	CEILING	INTERIOR ELEVATION DETAIL NUMBER	ROUGH CEILING HEIGHT	TRIM: METAL CASING	TRIM: WOOD STOPS	TRIM: W'D POST, MULLION, SILL & TRANSOM BAR	CABINETS: HARDWOOD FACE	CABINETS: STORAGE CABINET	CABINETS: SHELVES	CABINETS: WORKBENCH	CABINETS: INTERIOR DOORS	REMARKS
1	DIRECTOR'S OFFICE	2		2			4	4	4	4		1		8'-4½"	4	4	6					6	4	ACOUSTICAL TILE DET. - SEE 2.5/A12 & 1/A-11
2	MULTI-PURPOSE ROOM	2		2			4	4	4	4		1		8'-4½"	4	4	4	6				6	4	" " " " " "
3	MEN'S TOILET	2	1		1		5	5	5	5	1		4	8'-4½"	3	3	3			3		3	
4	WOMEN'S TOILET	2			1		5	5	5	5			4	8'-4½"	3	3	3			3		3	
5	VESTIBULE	2			1		4	4	4	4			4	8'-4½"	3	3	3					3	3
6	STORAGE	2			1		3	3	3	3			3	8'-4½"	3	3							3
7	PHONE BOOTH	2			1	•	1	1	1	1			1	8'-4½"	1								
8	JANITOR ⚠1	2			1		3	3	3	3			3	8'-4½"	3	3	3			3		3	
9	PARK STORAGE ROOM	2			1		3	3	3	3			3	8'-4½"	3	3	3					3	
10	WATER HEATER COMPARTMENT	2			1	•	1	1	1	1			1	8'-4½"	1	4							4
11	SERVICE BUILDING	1				•		1		1		1		8'-8"	A & B/A-14		4	4		4		6	

INTERIOR PAINT KEY SEE SPECS.

Nº	FINISH - REFER TO FINISH SCHEDULE FOR LOCATION OF FINISHES
1	NO FINISH
2	COLORED CONCRETE
3	GLOSS ENAMEL
4	SEMI-GLOSS ENAMEL
5	CEMENT GLAZE
6	NATURAL FINISH

EXTERIOR FINISH SCHEDULE - SEE SPECS.

MATERIAL	FINISH
PLASTER	STUCCO PAINT
CONCRETE BLOCK	MASONRY PAINT
EXPOSED W'D. HEADER	ENAMEL
WOOD POST & MULLION	ENAMEL
WOOD FASCIA	ENAMEL
EXPOSED JOIST TAILS	ENAMEL
PLYWOOD PANELS	ENAMEL
EXTERIOR DOORS	ENAMEL
WOOD SILLS & TRANSOM BARS	ENAMEL
WOOD WINDOW & DOOR STOPS	ENAMEL
MISCELLANEOUS WOOD	ENAMEL

MATERIAL	FINISH
METAL GRAVELSTOP	ENAMEL
METAL CASING BEAD	ENAMEL
METAL EXPANSION SCREED	ENAMEL
METAL LOUVER VENTS	ENAMEL
METAL SLAT ROLL-UP DOOR	ENAMEL
METAL MESH GATE	ENAMEL

DOOR SCHEDULE

MARK	SIZE: WIDTH	SIZE: HEIGHT	SIZE: THICK	SYM.	TYPE	MATERIAL	GLASS	LOUVER	KICK PLATE	ACTION	FRAME DETAIL NUMBER: HEAD	FRAME DETAIL NUMBER: JAMB	FRAME DETAIL NUMBER: THRESHOLD	Nº REQ.	REMARKS	MARK
D-1	3'-0"	6'-8"	1¾"	A	SOLID STILES & RAILS - GLAZED	PAINT GR. W'D.	14" SQ. WIRE	—	YES	SWING	9/A10	6,10/A10	30/A10	2		D-1
D-2	PR. 5'-0"	6'-8"	1¾"	B	S.C. FLUSH 1 LITE	PAINT GR. W'D.	¼" POL. PLATE	—	YES	SWING	9/A10	10,23/A10	30/A10	1		D-2
D-3	3'-0"	6'-8"	1¾"	C	S.C. FLUSH	PAINT GR. W'D.	—	—	YES	SWING	11,13/A10	15/A10	32/A10 SIM.	4		D-3
D-4	3'-0"	6'-8"	1¾"	D	S.C. FLUSH	PAINT GR. W'D.	—	—	—	SWING	11,13/A10	15/A10	30/A10	1		D-4
D-5	1'-8"	6'-8"	1¾"	F	S.C. FLUSH	PAINT GR. W'D.	—	—	—	SWING	11,12/A10	10/A10	30/A10	1		D-5
D-6	PR. 5'-0"	6'-8"	1¾"	G	LOUVER	PAINT GR. W'D.	—	FULL HEIGHT METAL LOUVER	—	SWING	11,13/A10	15/A10	30/A10	1		D-6
D-7	3'-0"	6'-8"	1¾"	C	S.C. FLUSH	PAINT GR. W'D	—	—	—	SWING	11,12/A10	15/A10	30/A10	1		D-7
D-8	3'-0"	6'-8"	1¾"	J	S.C. FLUSH	PAINT GR. W'D.	—	—	YES	SWING	10/A10	14/A10	—	4		D-8
D-9	3'-0"	6'-8"	1⅜"	K	FLUSH	METAL	—	15" W. 24" TOP & BOT.	—	SLIDING	10/A10	17,18/A10	—	2	SEE SPECS.	D-9
D-10	3'-0"	6'-8"	1¾"	E	S.C. FLUSH	HARDW'D.	—	—	YES	SWING	9/A10	14/A10	—	1		D-10
D-11	PR. 5'-0"	6'-8"	1⅜"	L	H.C. FLUSH	HARDW'D.	—	—	—	SWING	21/A12	23/A12	—	1		D-11
D-12	PR. 4'-0"	6'-8"	1⅜"	L	H.C. FLUSH	HARDW'D.	—	—	—	SWING	21/A12	22,23/A12	—	2		D-12
D-13	PR. 3'-0"	6'-8"	1⅜"	L	H.C. FLUSH	HARDW'D.	—	—	—	SWING	21/A12	23/A12	—	2		D-13
D-14	2'-6"	6'-8"	1⅜"	M	H.C. FLUSH	HARDW'D.	—	—	—	SWING	21/A12	23/A12	—	1		D-14
D-15	PR. 6'-0"	6'-8	1¾"	H	S.C. FLUSH	PAINT GR. W'D	—	—	—	SWING	9/A12	10/A12	31/A12	1		D-15

WINDOW SCHEDULE

MARK	SIZE: WIDTH	SIZE: HEIGHT	SYM.	TYPE	MATERIAL	GLASS: FIXED	GLASS: OPERABLE	FRAME DETAIL NUMBER: HEAD	FRAME DETAIL NUMBER: JAMB	FRAME DETAIL NUMBER: MULLION	FRAME DETAIL NUMBER: SILL	Nº REQ.	REMARKS	MARK
W-1	5'-0"	4'-0"	B	SLIDING	ALUM.	¼" SQ. WIRE	¼" SQ. WIRE	1/A10	4,8/A10	2/A10	3/A10	4	PROVIDE SPACE FOR VERT. VENITIAN BLINDS N.I.C.	W-1
W-2	5'-0"	4'-0"	B	SLIDING	ALUM.	CLEAR D'BL. ST'R.	CLEAR D'BL. ST'R.	1/A10	2,4/A10	2,23/A10	3/A10	3		W-2
W-3	1'-4"	4'-0"	A	FIXED	WOOD STOPS	¼" SQ. WIRE	—	5/A10	8/A10	6/A10	7/A10	2	PROVIDE SPACE FOR VERT VENITIAN BLINDS N.I.C.	W-3

DOOR TYPES - 1/4" = 1'-0"

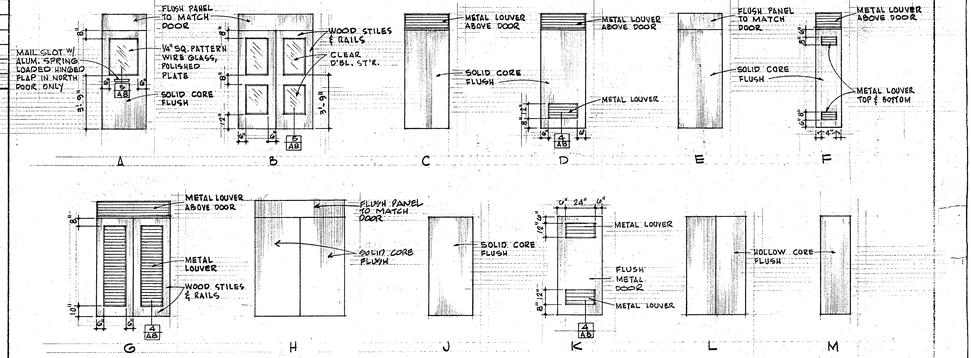

WINDOW TYPES - 1/4" = 1'-0"

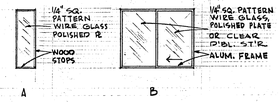

NAILING SCHEDULE - COMMON NAILS

CONNECTION	NAILS
STUD TO PLATE - END NAIL	2-16d
STUD TO PLATE - TOE NAIL	3-16d OR 4-8d
TOP PLATES - SPIKE TOGETHER	16d @ 16" O.C.
TOP PLATES - LAPS AND INTERSECTIONS	2-16d
CEILING JOISTS - TO PLATE - TOE NAIL	2-16d
CEILING JOISTS - LAPS OVER PARTITIONS	3-16d
CEILING JOISTS TO PARALLEL ALTERNATE RAFTERS	3-16d
RAFTER TO PLATE	3-16d
CONTINUOUS 1-INCH BRACE TO STUD	2-8d
CORNER STUDS AND ANGLES	16d @ 24" OC.
BRIDGING TO JOIST-TOE NAIL	2-8d

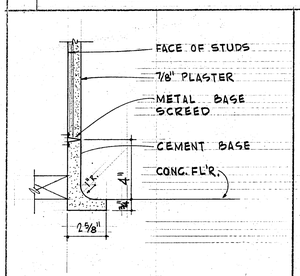

1/A8 CEMENT BASE 3"=1'-0"

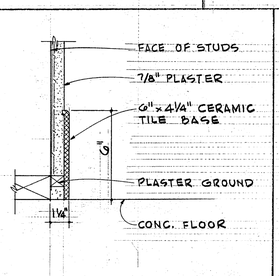

2/A8 CERAMIC TILE BASE 3"=1'-0"

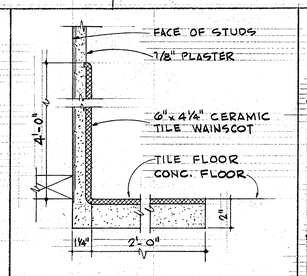

3/A8 CERAMIC TILE WAINSCOT 3"=1'-0"

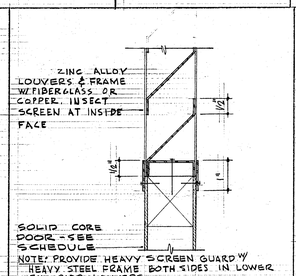

4/A8 DOOR - LOUVER HALF SIZE

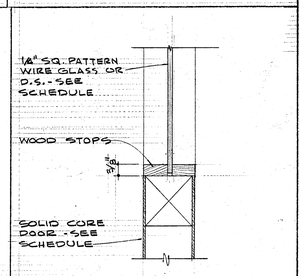

5/A8 DOOR - GLASS PANEL HALF SIZE

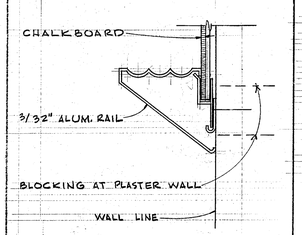

6/A8 CHALK RAIL HALF SIZE

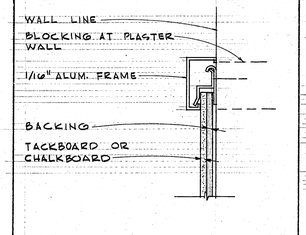

7/A8 CHALKBOARD OR TACKBOARD EDGE HALF SIZE

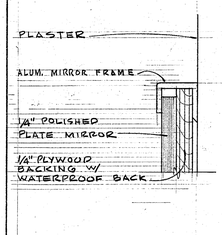

8/A8 MIRROR FRAME FULL SIZE

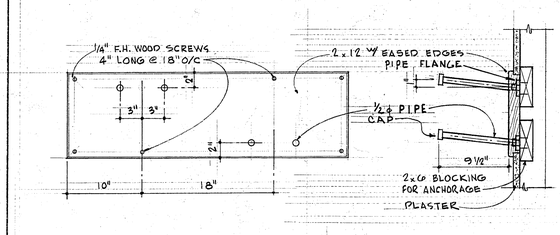

9/A8 MOP RACK DETAILS 1½" = 1'-0"

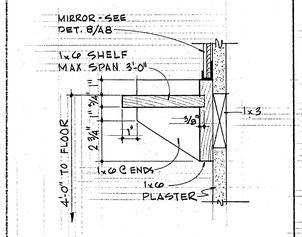

10/A8 LAVATORY SHELF 3"=1'-0"

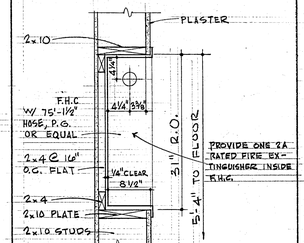

11/A8 FIRE HOSE CABINET 1"=1'-0"

ABBREVIATIONS

A.C.	ASPHALTIC CONCRETE
ADJ.	ADJUSTABLE
ALT.	ALTERNATE
ALUM.	ALUMINIUM
ASPH.	ASPHALT
BEARG.	BEARING
BLD'G.	BUILDING
BLK'G	BLOCKING
BOT.	BOTTOM
CONTR.	CONTRACTOR
CAB.	CABINET
CEIL. OR CL'G.	CEILING
CHAN.	CHANNEL
COMPO.	COMPOSITION
CONC.	CONCRETE
CONT.	CONTINUOUS
CONSTR.	CONSTRUCTION
D'BL.	DOUBLE
DET.	DETAIL
D.F.	DOUGLAS FIR OR DRINKING FOUNTAIN
DIA.	DIAMETER
DR.	DOOR
DWR.	DRAWER
EA.	EACH
EL. OR ELEV.	ELEVATION
ELEC.	ELECTRICAL
EXT.	EXTERIOR
F.F.	FINISH FLOOR
FIN.	FINISH
F.H.C.	FIRE HOSE CABINET
FL'R.	FLOOR
FURN.	FURNACE
F.G.	FINISH GRADE
GA.	GAUGE
GALV. OR GI.	GALVANIZED
GR. OR GRD.	GRADE
GYP.	GYPSUM
HGT.	HEIGHT
H.C.	HOLLOW CORE
HDR.	HEADER
HORIZ.	HORIZONTAL
INT.	INTERMEDIATE OR INTERIOR
JST.	JOIST
INV.	INVERT
LAV.	LAVATORY
L.F.	LINEAL FEET
MAX.	MAXIMUM
MECH.	MECHANICAL
MET.	METAL
M.H.	MAN HOLE
MIN	MINIMUM OR MINERAL
RET.	RETAINING
N.I.C.	NOT IN CONTRACT
N.G.	NATURAL GRADE
O.C.	ON CENTER
P.T.	PRESSURE TREATED
PL.	PLATE
PLAS.	PLASTER
P.S.I.	POUNDS PER SQUARE INCH
RW'D OR REDW'D	REDWOOD
REINF.	REINFORCING
S.S.	SERVICE SINK
S.C.	SOLID CORE
SH.	SHELF
SHT.	SHEET
SHTG.	SHEATHING
SPECS.	SPECIFICATIONS
SQ.	SQUARE
ST'L.	STEEL
S.F.	SQUARE FEET
TYP.	TYPICAL
T.P.	TOP OF PAVING
U.	URINAL
STD.	STANDARD
VERT.	VERTICAL
FL.	FLUSH
W/	WITH
W.C.	WATER CLOSET
W.H.	WATER HEATER
WD.	WOOD
W.R	WATER PROOF
T.C.	TOP OF CURB OR CONCRETE
T.W.	TOP OF WALL

AS BUILT

EDWIN H. RIPPERDAN
ARCHITECT
3610 LONG BEACH BLVD. · LONG BEACH · CALIF. 424-6701
C-2309

REVISIONS
2/27/70 COL. CONC. FLR. ADDED

ACTIVITY BUILDING & GENERAL DEVELOPMENT FOR THE COUNTY OF LOS ANGELES
PALOS VERDES COUNTY PARK
30359 S. HAWTHORNE BLVD. PALOS VERDES · CALIFORNIA

FINISH, DOOR, WINDOW SCHEDULE & DETAILS

AS-BUILT CORRECTIONS	SCALE:	DRAWN BY:	CHECKED BY:	DATE:	CAP. PROJ. Nº: 68-59-02	SHEET
2/27/70	AS NOTED	HLC,	EHR	6-8-64 REVISED: 8-24-65 9-27-68	SPEC. Nº 2379 ARCH. JOB Nº 628	A8 OF 14

EAST FILE CORP., IRVINE, CA HANGER ST-10

RPV Park
Finish, door, window
Schedule & Details

1201

A-8